

STONE

L 2015

5-9-80

MISSISSIPPI
 BOARD OF WATER COMMISSIONERS
 416 North State Street
 Jackson, Mississippi 39201

WATER WELL DRILLERS LOG

5-9 1980 Braden Pump + Well Stone
 date well completed firm name county well located
 Ser. Inc.

LANDOWNER:

Charles Vernon Fleming
Rt. 3 Box 87

description of formations encountered

from to

Perkinston, MS 39573
(mailing address)

Clay	0	10
Sand	10	32
Clay	32	140
Sand	140	170

WELL LOCATION:

sec. 4 T 4 S R 11 W
 2 miles EAST of Mettern
 (distance) (direction) (nearest town)

WELL PURPOSE: home
 (home, irrigation, municipal, industrial)

WELL COMPLETION DATA:

- (1) diameter (inches) 2"
- (2) total depth (feet) 170'
- (3) static water level (feet) 108' below top of ground.
- (4) casing PVC, total (depth)
2" (size) If telescope see back.
- (5) screen 10' (length), 160' (depth to top)
2" (size), 100% PVC underdrain (material)
- (6) pump 1 1/2 (HP), 10 (yield gpm)
230 (type power)
- (7) electric log no (yes or no)
(organization running log)
- (8) how well bottom plugged
2" sand swab

DEPT. OF NATURAL RESOURCES
 BUREAU OF LAND & WATER RESOURCES


JUN 25 1980

RECEIVED

DRILLERS REMARKS:

If well telescopes please sketch and show depths.

GROUND LEVEL

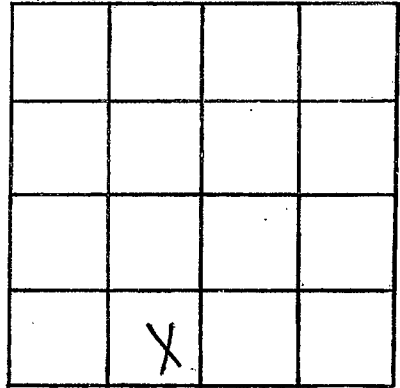

SECTION 4

Please indicate well location X.

ADDITIONAL INFORMATION

If more than one screen, show locations of each on sketch.