

MISSISSIPPI DEPARTMENT OF NATURAL RESOURCES

Bureau of Land and Water Resources

Southport Mall

P.O. Box 10631

Jackson, Mississippi 39209

WATER WELL DRILLERS LOG

STONE
L 2000
/80

C LADNER

date

date well completed 1980 NOV 3 1980 firm name LADNER Stone county well located _____

LANDOWNER:	description of formations encountered	from	to
<u>FELDER ONEAL</u>	<u>0-8 ft.</u>		
<u>RT 3 BOX 138</u>	<u>TOP SOIL</u>	<u>0</u>	<u>8</u>
<u>PERKINSON</u> (mailing address)	<u>IRON ROCK</u>	<u>8</u>	<u>10</u>
WELL LOCATION:	<u>WHITE COURSE SAND</u>	<u>10</u>	<u>28</u>
sec. <u>4</u> T. <u>4</u> N. R. <u>11</u> E.	<u>CLAY</u>	<u>28</u>	<u>29</u>
<u>3</u> miles (distance) <u>NE</u> (direction) of <u>McHenry</u> (nearest town)			
WELL PURPOSE: <u>HOME</u> (home, irrigation, municipal, industrial)			
WELL COMPLETION DATA:			
(1) diameter (inches) <u>2</u>			
(2) total depth (feet) <u>28</u>			
(3) static water level (feet) <u>10</u> below top of ground.			
(4) casing <u>PLASTIC</u> (material), <u>18</u> (depth)			
_____ (size) if telescope see back.			
(5) screen <u>10</u> (length), <u>18</u> (depth to tap)			
<u>2</u> (size), <u>PLASTIC</u> (material)			
(6) pump <u>1/2</u> (HP), <u>3 1/2</u> (yield gpm)			
<u>ELOS</u> (type power)			
(7) electric log <u>NO</u> (yes or no)			
_____ (organization running log)			
(8) how well bottom plugged <u>PLASTIC CAP</u>			

DEPT. OF NATURAL RESOURCES
BUREAU OF LAND & WATER RESOURCES


DEC - 3 1980

RECEIVED

DRILLERS REMARKS:

If well telescopes please
sketch and show depths.

GROUND LEVEL

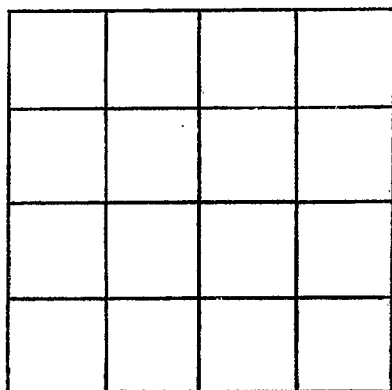

SECTION _____

Please indicate well location X.

ADDITIONAL INFORMATION

If more than one screen,
show locations of each on sketch.