

MISSISSIPPI DEPARTMENT OF NATURAL RESOURCES

Bureau of Land and Water Resources

Southport Mall

P.O. Box 10631

Jackson, Mississippi 39209

WATER WELL DRILLERS LOG

CLADMER

STONE
L 2017
10-10-80

date well completed 19 NOV 10 80 firm name NIRON LADON county well located STONE

LANDOWNER:	description of formations encountered	from	to
<u>NUBERT NARRIMORE</u>	<u>TOP SOIL ROCKS</u>	<u>0</u>	<u>10</u>
<u>Rt 3 DERKINSON MS</u> (mailing address)	<u>CLAY</u>	<u>10</u>	<u>11</u>
<u>WELL LOCATION:</u>	<u>SAND WHITE</u>	<u>11</u>	<u>20</u>
sec. <u>4</u> T. <u>4</u> N. R. <u>11</u> E	<u>WHITE SAND PER</u>	<u>20</u>	<u>28</u>
<u>35</u> miles <u>E</u> of <u>MCHENRY</u>	<u>GRAVEL</u>		
(distance) (direction) (nearest town)			
<u>WELL PURPOSE:</u> (home, irrigation, municipal, industrial)			
<u>WELL COMPLETION DATA:</u>			
(1) diameter (inches) <u>2</u>			
(2) total depth (feet) <u>28</u>			
(3) static water level (feet) <u>6'</u> <u>below</u> top of ground.			
(4) casing <u>PLASTIC 18</u> (material) (depth)			
(size) if telescope see back.			
(5) screen <u>10 18</u> (length) (depth to top)			
<u>2</u> (size) <u>PLASTIC</u> (material)			
(6) pump <u>1 12</u> (HP) (yield gpm)			
<u>ALFC</u> (type power)			
(7) electric log <u>NO</u> (yes or no)			
(organization running log)			
(8) how well bottom plugged <u>PLASTIC CAP</u>			
<u>DRILLERS REMARKS:</u>			


DEPT. OF NATURAL RESOURCES
BUREAU OF LAND & WATER RESOURCES

DEC 3 1980

RECEIVED

If well telescopes please sketch and show depths.

GROUND LEVEL

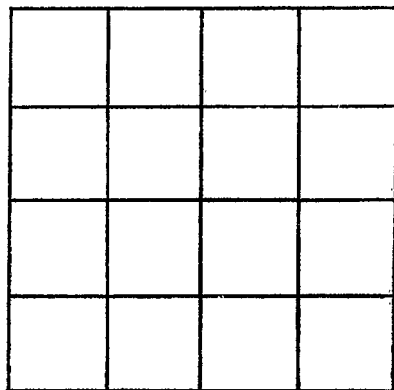

SECTION _____

Please indicate well location X.

ADDITIONAL INFORMATION

If more than one screen,
show locations of each on sketch.