

MISSISSIPPI DEPARTMENT OF NATURAL RESOURCES

Bureau of Land and Water Resources

Southport Mall

P.O. Box 10631

Jackson, Mississippi 39209

WATER WELL DRILLERS LOG

Stone  
L 205  
11-20-81

11-20 date well completed 1981 Frank Price Stone firm name Stone county well located

LANDOWNER:  
Mike Parker  
  
(mailing address)

description of formations encountered	from	to
Top Soil	0	3
Smiley Clay	3	14
Course Sand	14	50

WELL LOCATION:  
sec. 5 T 4 N R 11 E  
3 miles S of Perk  
(distance) (direction) (nearest town)

WELL PURPOSE: HOME  
(home, irrigation, municipal, industrial)

WELL COMPLETION DATA:

(1) diameter (inches) 2"  
(2) total depth (feet) 50'  
(3) static water level (feet) 35' below top of ground.  
(4) casing Plastic 45' (material) (depth)  
If telescope see back.  
(5) screen 5' 45' (length) (depth to top)  
2" Plastic (size) (material)  
(6) pump 1/2 4 (HP) (yield gpm)  
Elect (type power)  
(7) electric log No (yes or no)  
(organization running log)  
(8) how well bottom plugged Capped

DRILLERS REMARKS:


DEPT. OF NATURAL RESOURCES  
BUREAU OF LAND & WATER RESOURCES

DEC - 9 1981

RECEIVED

If well telescopes please sketch and show depths.

GROUND LEVEL

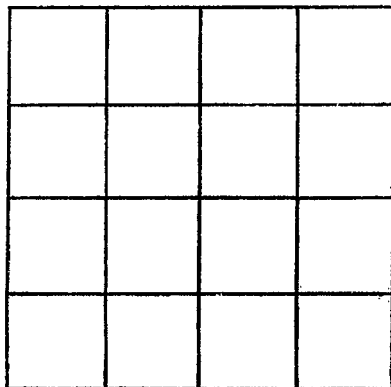

SECTION \_\_\_\_\_

Please indicate well location X.

ADDITIONAL INFORMATION

If more than one screen, show locations of each on sketch.