

Stone  
L 2000  
12/8/81

MISSISSIPPI  
BOARD OF WATER COMMISSIONERS  
416 North State Street  
Jackson, Mississippi 39201

WATER WELL DRILLERS LOG

Dec 8 1981 Farmer Anderson Stone  
date well completed firm name county well located

LANDOWNER: <u>Virgil Patton</u>	description of formations encountered	from	to
<u>Rt 3</u>	<u>Top Soil</u>	<u>0</u>	<u>3</u>
<u>Derbinston Ms 39543</u>	<u>Clay</u>	<u>3</u>	<u>16</u>
(mailing address)	<u>sand</u>	<u>16</u>	<u>38</u>
WELL LOCATION:	<u>Clay</u>	<u>38</u>	<u>40</u>
sec <u>3</u> T <u>4</u> N R <u>11</u> E	<u>sand</u>		
<u>92</u> miles S of <u>Wiggins</u>			
(distance) (direction) (nearest town)			
WELL PURPOSE: <u>Home</u> (home, irrigation, municipal, industrial)			
WELL COMPLETION DATA:			
(1) diameter (inches) <u>2"</u>			
(2) total depth (feet) <u>40'</u>			
(3) static water level (feet) <u>35</u> below top of ground.			
(4) casing <u>Pvc</u> , <u>35'</u> (material) (depth)			
_____ if telescope see back. (size)			
(5) screen <u>5'</u> , <u>35'</u> (length) (depth to top)			
<u>2"</u> , <u>Pvc</u> (size) (material)			
(6) pump <u>1</u> , <u>8</u> (HP) (yield gpm)			
<u>Electric</u> (type power)			
(7) electric log <u>NO</u> (yes or no)			
_____ (organization running log)			
(8) how well bottom plugged <u>Capped</u>			
DRILLERS REMARKS:			


DEPT. OF NATURAL RESOURCES  
BUREAU OF LAND & WATER RESOURCES

DEC 20 1981

RECEIVED

If well telescopes please sketch and show depths.

GROUND LEVEL

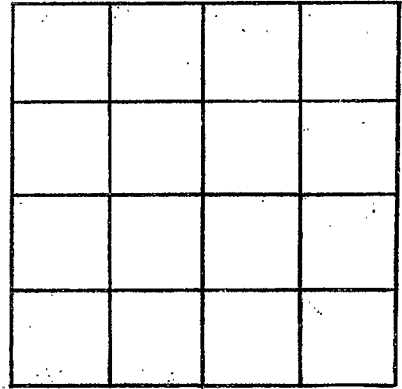

SECTION \_\_\_\_\_

Please indicate well location X.

ADDITIONAL INFORMATION

If more than one screen, show locations of each on sketch.