

Stone
L 202
1-7-81

MISSISSIPPI
BOARD OF WATER COMMISSIONERS
416 North State Street
Jackson, Mississippi 39201

WATER WELL DRILLERS LOG

Stone County

1-7-1981 date well completed
McKee well works firm name

county well located

LANDOWNER: Keith Raymond
109 Pecan Dr
Long Beach Mo.
(mailing address)

| description of formations encountered | from | to |
|---------------------------------------|------|-----|
| sand | 1 | 30 |
| mud | 30 | 80 |
| blue clay | 80 | 120 |
| mud | 120 | 160 |
| sand - mud | 160 | 200 |
| mud | 200 | 250 |
| 1" rock | 250 | |
| mud sand | 250 | 260 |
| fine sand | 260 | 265 |
| caliche sand | 265 | 280 |

WELL LOCATION: McHenry
sec. 30 T 5 N R 11 E
4 miles E of McKee Mo.
(distance) (direction) (nearest town)

WELL PURPOSE: home
(home, irrigation, municipal, industrial)

- WELL COMPLETION DATA:
- (1) diameter (inches) 4"
 - (2) total depth (feet) 280'
 - (3) static water level (feet) 100' below top of ground.
 - (4) casing PVC 270' (material) (depth)
4" if telescope see back. (size)
 - (5) screen 10' (length) (depth to top)
4" (size) plastic (material)
 - (6) pump 2 hp. 20 (HP). (yield gpm)
electric (type power)
 - (7) electric log no (yes or no)
 - (organization running log)
 - (8) how well bottom plugged sand shark

DEPT. OF NATURAL RESOURCES
BUREAU OF LAND & WATER RESOURCES

SEP - 7 1982


RECEIVED

DRILLERS REMARKS:

If well telescopes please sketch and show depths.

18-7-1

GROUND LEVEL

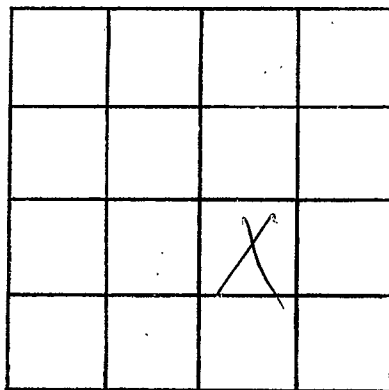

SECTION

30

Please indicate well location X.

ADDITIONAL INFORMATION

If more than one screen, show locations of each on sketch.