

MISSISSIPPI DEPARTMENT OF NATURAL RESOURCES

Bureau of Land and Water Resources

Southport Mall

P.O. Box 10631

Jackson, Mississippi 39209

WATER WELL DRILLERS LOG

Stone
L
2022

4-12-82  
date well completed

Frank Price  
firm name

Stone  
county well located

LANDOWNER:	description of formations encountered	from	to
Don Oreal	Top Soil	0	3
(mailing address)	Red Clay	3	20
WELL LOCATION:	Course Sand	20	45
sec. 18 T. 4 R. 11 S. W.			
1 miles S of McHenry			
WELL PURPOSE: HOME			
(home, irrigation, municipal, industrial)			
WELL COMPLETION DATA:			
(1) diameter (inches) 2			
(2) total depth (feet) 45			
(3) static water level (feet) 30 below top of ground.			
(4) casing (material) Plastic (depth) 40'			
(size) if telescope see back.			
(5) screen (length) 5' (depth to top) 40'			
(size) (material) 2 Plastic			
(6) pump (HP) 1/2 (yield gpm) 6			
(type power) Elect			
(7) electric log no (yes or no)			
(organization running log)			
(8) how well bottom plugged Capped			

DEPT. OF NATURAL RESOURCES  
BUREAU OF LAND & WATER RESOURCES


MAY 10 1982

RECEIVED

DRILLERS REMARKS:

If well telescopes please sketch and show depths.

GROUND LEVEL

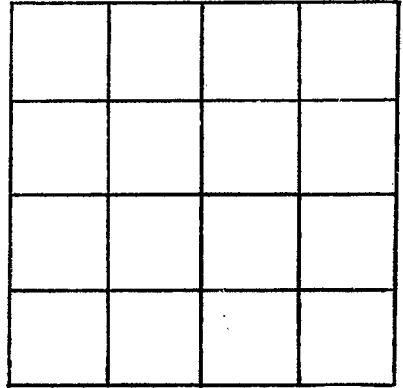

SECTION \_\_\_\_\_

Please indicate well location X.

ADDITIONAL INFORMATION

If more than one screen,  
show locations of each on sketch.