

MISSISSIPPI DEPARTMENT OF NATURAL RESOURCES

Bureau of Land and Water Resources

Southport Mall

P.O. Box 10631

Jackson, Mississippi 39209

WATER WELL DRILLERS LOG

Stone
L
2024

11-17 1982
date well completed

Frank Price
firm name

Stone
county well located

LANDOWNER:
Jimmy Bowles
(mailing address)

description of formations encountered	from	to
<u>Top Soil</u>	<u>0</u>	<u>2</u>
<u>Clay</u>	<u>2</u>	<u>190</u>
<u>Coarse Sand</u>	<u>190</u>	<u>272</u>

WELL LOCATION:
sec 3 T 4 N R 11 E
2 miles E of McVenny
(distance) (direction) (nearest town)

WELL PURPOSE: HOME
(home, irrigation, municipal, industrial)

WELL COMPLETION DATA:

(1) diameter (inches) 2

(2) total depth (feet) 272

(3) static water level (feet) 130 below above top of ground.

(4) casing Plastic, 217'
(material) (depth)

_____ If telescope see back.
(size)

(5) screen 5 217
(length) (depth to top)

2 Plastic
(size) (material)

(6) pump 2 6
(HP) (yield gpm)

Elect
(type power)

(7) electric log no
(yes or no)

_____ (organization running log)

(8) how well bottom plugged Back with 1/2" pipe


DRILLERS REMARKS:

DEPT. OF NATURAL RESOURCES
BUREAU OF LAND & WATER RESOURCES

DEC-6 1982
RECEIVED

If well telescopes please sketch and show depths.

GROUND LEVEL

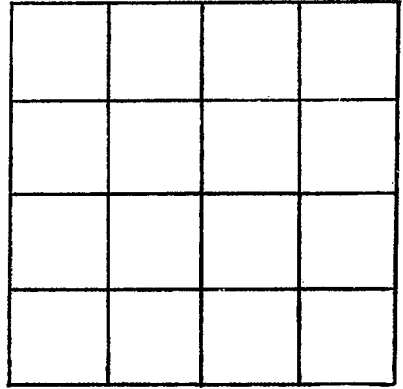

SECTION _____

Please indicate well location X.

ADDITIONAL INFORMATION

If more than one screen,
show locations of each on sketch.