

Stone
L 2025

MISSISSIPPI
BOARD OF WATER COMMISSIONERS
416 North State Street
Jackson, Mississippi 39201

WATER WELL DRILLERS LOG

Feb. 11 1982 Parnee Anderson Stone
date well completed firm name county well located

LANDOWNER: Thommy Mast
St 3
Perkinston, MS
(mailing address)

WELL LOCATION:
sec. 9 T. 4 N. R. 11 E.
S. W.
1.0 miles S of Wiggins
(distance) (direction) (nearest town)

WELL PURPOSE: Home
(home, irrigation, municipal, industrial)

WELL COMPLETION DATA:

(1) diameter (inches) 2"

(2) total depth (feet) 266'

(3) static water level (feet) 160' below top of ground.

(4) casing PVC
(material) (depth)
(size) if telescope see back.

(5) screen 10' 140'
(length) (depth to top)
2" PVC
(size) (material)

(6) pump 1 1/2 350
(HP) (yield gpm)
Electric
(type power)

(7) electric log no
(yes or no)
(organization running log)

(8) how well bottom plugged Capped

description of formations encountered	from	to
top soil	0	2
clay	2	18
Fine sand	18	32
Blue clay	32	210
Fine sand	210	240
coarse sand	240	266

DRILLERS REMARKS:


DEPT. OF NATURAL RESOURCES
BUREAU OF LAND & WATER RESOURCES

FEB - 2 1982

RECEIVED

If well telescopes please
sketch and show depths.

GROUND LEVEL

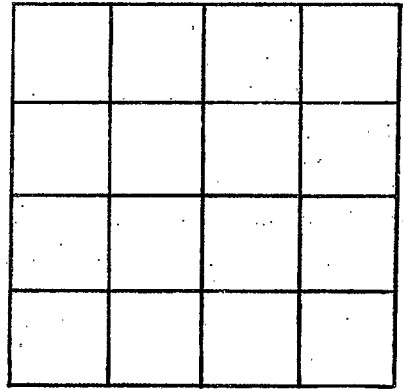

SECTION _____

Please indicate well location X.

ADDITIONAL INFORMATION

If more than one screen,
show locations of each on sketch.