

MISSISSIPPI DEPARTMENT OF NATURAL RESOURCES

Bureau of Land and Water Resources

Southport Mall

P.O. Box 10631

Jackson, Mississippi 39209

WATER WELL DRILLERS LOG

Stone
L
2020

5-10 1983 date well completed Frank Pisci Stone firm name Stone county well located

LANDOWNER: Willie Beach
 (mailing address)

WELL LOCATION:
 sec. 8 T 4 N R 11 E
1/2 miles E of McHenry
 (distance) (direction) (nearest town)

WELL PURPOSE: HOME
 (home, irrigation, municipal, industrial)

WELL COMPLETION DATA:

(1) diameter (inches) 4"

(2) total depth (feet) 197'

(3) static water level (feet) 247' above top of ground.

(4) casing Plastic, 192'
 (material) (depth)
 (size) if telescope see back.

(5) screen 5', 192'
 (length) (depth to top)
4", Plastic
 (size) (material)

(6) pump 3/4 10
 (HP) (yield gpm)
Elect
 (type power)

(7) electric log no
 (yes or no)

(organization running log)

(8) how well bottom plugged B.W.V.


description of formations encountered	from	to
Top Soil	0	3
Sandy Clay	3	15'
White Clay	15	28
Blue Clay	28	185
Coarse Sand	185	197

DRILLERS REMARKS:

DEPT. OF NATURAL RESOURCES
 BUREAU OF LAND & WATER RESOURCES
 JUN 20 1983
RECEIVED

If well telescopes please sketch and show depths.

GROUND LEVEL

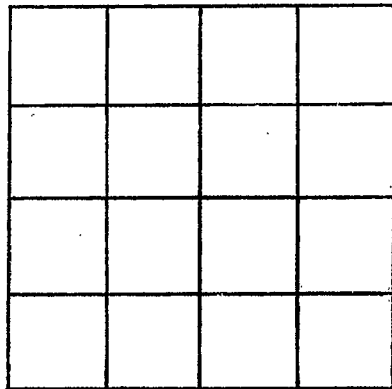

SECTION _____

Please indicate well location X.

ADDITIONAL INFORMATION

If more than one screen, show locations of each on sketch.