

MISSISSIPPI DEPARTMENT OF NATURAL RESOURCES

Bureau of Land and Water Resources

Southport Mall

P.O. Box 10631

Jackson, Mississippi 39209

WATER WELL DRILLERS LOG

Stone
L
2020

7-18 1983
 date well completed

Frank Rice
 firm name

Stone
 county well located

LANDOWNER:

Harold McKee

(mailing address)

WELL LOCATION:

sec. 8 T. 4 N. R. 11 E. S. 1 W. McHenry
 1 1/2 miles E of (nearest town)
 (distance) (direction)

WELL PURPOSE:

HOME (home, irrigation, municipal, industrial)

WELL COMPLETION DATA:

- (1) diameter (inches) 4" x 2"
- (2) total depth (feet) 238'
- (3) static water level (feet) 98' below top of ground.
- (4) casing Plastic 228' (material) (depth)
4" x 2" (size) If telescope see back.
- (5) screen 10' 228' (length) (depth to top)
2" Plastic (size) (material)
- (6) pump 1 25 (HP) (yield gpm)
Elect (type power)
- (7) electric log no (yes or no)

(organization running log)

(8) how well bottom plugged B.W.V.

DRILLERS REMARKS:

description of formations encountered

from

to

Top Soil	0	3
Red Clay	3	18
Blue Clay	18	195
Fine Sand	195	215
Coarse Sand	215	238



DEPT. OF NATURAL RESOURCES
 BUREAU OF LAND & WATER RESOURCES

SEP 12 1983

RECEIVED

If well telescopes please sketch and show depths.

GROUND LEVEL

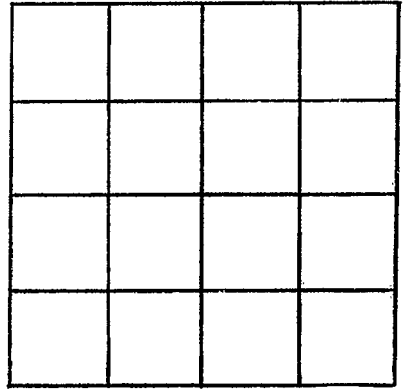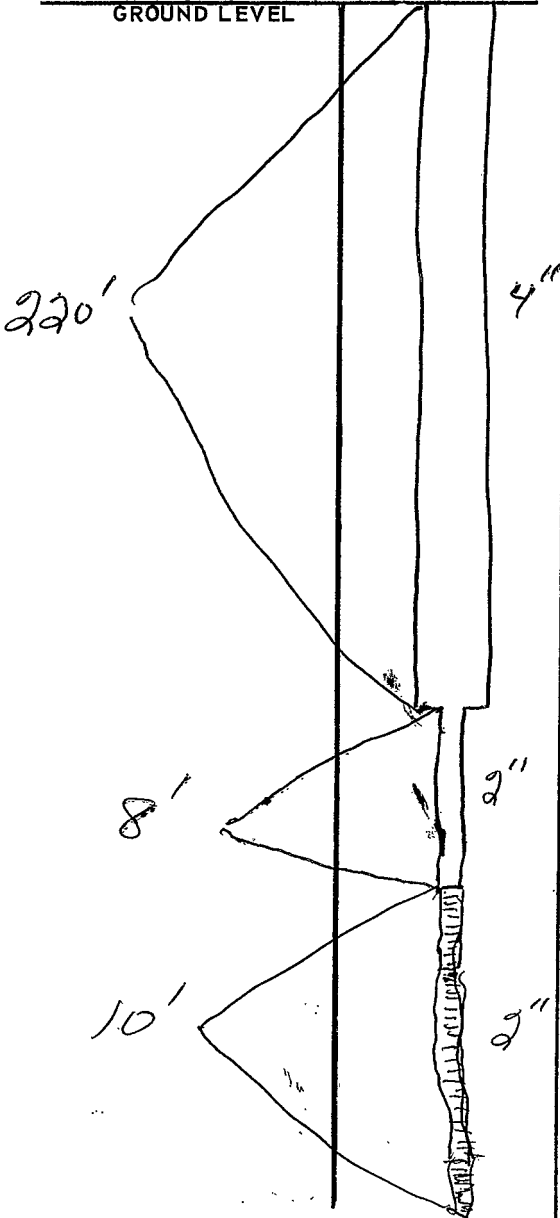

SECTION _____

Please indicate well location X.

ADDITIONAL INFORMATION

A series of horizontal lines for providing additional information.

If more than one screen, show locations of each on sketch.