

MISSISSIPPI DEPARTMENT OF NATURAL RESOURCES

Bureau of Land and Water Resources

Southport Mall

P.O. Box 10631

Jackson, Mississippi 39209

WATER WELL DRILLERS LOG

Stone  
L 2018

8-6 1983 Frank Price Stone  
date well completed firm name county well located

LANDOWNER: Bruce Lott  
  
(mailing address)

description of formations encountered	from	to
<u>Top Soil</u>	<u>0</u>	<u>3</u>
<u>Clay</u>	<u>3</u>	<u>190</u>
<u>Coarse Sand</u>	<u>190</u>	<u>280</u>

WELL LOCATION:  
sec. 9 T 4 N R. 11 E  
2 miles S of McHenry  
(distance) (direction) (nearest town)

WELL PURPOSE: HOME  
(home, irrigation, municipal, industrial)

WELL COMPLETION DATA:

(1) diameter (inches) 4"

(2) total depth (feet) 280'

(3) static water level (feet) 93 below top of ground.

(4) casing Plastic, 210',  
(material) (depth)  
(size) if telescope see back.

(5) screen 10', 210  
(length) (depth to top)  
4", Plastic  
(size) (material)

(6) pump 1 30  
(HP) (yield gpm)  
Electric  
(type power)

(7) electric log no  
(yes or no)  
  
(organization running log)

(8) how well bottom plugged B.W.V.

DRILLERS REMARKS:


DEPT. OF NATURAL RESOURCES  
BUREAU OF LAND & WATER RESOURCES

SEP 12 1983

RECEIVED

If well telescopes please sketch and show depths.

GROUND LEVEL

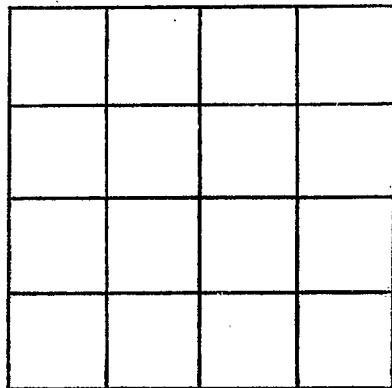

SECTION \_\_\_\_\_

Please indicate well location X.

ADDITIONAL INFORMATION

If more than one screen,  
show locations of each on sketch.