

MISSISSIPPI DEPARTMENT OF NATURAL RESOURCES

Bureau of Land and Water Resources

Southport Mall

P.O. Box 10631

Jackson, Mississippi 39209

WATER WELL DRILLERS LOG

Stone  
L  
2030

Frank Price

Stone

3-2-84 19  
date well completed

firm name

county well located

LANDOWNER: Wiley Wedgworth  
  
(mailing address)

description of formations encountered	from	to
<u>Top Soil</u>	<u>0</u>	<u>2</u>
<u>Red clay</u>	<u>2</u>	<u>23</u>
<u>Blue Clay</u>	<u>25</u>	<u>190</u>
<u>Fine Sand</u>	<u>190</u>	<u>220</u>
<u>Coarse Sand</u>	<u>220</u>	<u>235</u>

WELL LOCATION:  
sec. 8 T 4 S R 11 E W  
1 miles E of McMurray  
(distance) (direction) (nearest town)

WELL PURPOSE: home  
(home, irrigation, municipal, industrial)

WELL COMPLETION DATA:

(1) diameter (inches) 4"

(2) total depth (feet) 235'

(3) static water level (feet) 140' below top of ground.

(4) casing Plastic 225'  
(material) (depth)

(size) If telescope see back.

(5) screen 10' 225'  
(length) (depth to top)

(size) PVC (material)

(6) pump 3/4 10  
(HP) (yield gpm)

Elect  
(type power)

(7) electric log no  
(yes or no)

(organization running log)

(8) how well bottom plugged B.W.V.

DRILLERS REMARKS:


DEPT. OF NATURAL RESOURCES  
BUREAU OF LAND & WATER RESOURCES

APR 10 1984

RECEIVED

If well telescopes please sketch and show depths.

GROUND LEVEL

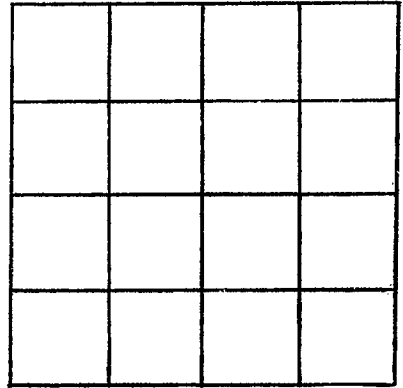

SECTION \_\_\_\_\_

Please indicate well location X.

ADDITIONAL INFORMATION

If more than one screen,  
show locations of each on sketch.