

MISSISSIPPI DEPARTMENT OF NATURAL RESOURCES

Bureau of Land and Water Resources

Southport Mall

P.O. Box 10631

Jackson, Mississippi 39209

WATER WELL DRILLERS LOG

STONE  
L 2031

6-1  
date well completed

84 Frank Price  
firm name

Stone  
county well located


LANDOWNER:	description of formations encountered	from	to
Danny Ray Howard (mailing address)			
	Clay	2	170
	Coarse Sand	170	195
WELL LOCATION:			
sec. 2 T. 4 N. R. 11 E S. 4 miles F of McHenry (distance) (direction) (nearest town)			
WELL PURPOSE: HOME (home, irrigation, municipal, industrial)			
WELL COMPLETION DATA:			
(1) diameter (inches) 2			
(2) total depth (feet) 195			
(3) static water level (feet) 120 below above top of ground.			
(4) casing PVC, 185 (material) (depth)			
(size) if telescope see back.			
(5) screen 10' length, 185 (depth to top)			
2" size, PVC (material)			
(6) pump 1 (HP) 5 (yield gpm)			
Elect (type power)			
(7) electric log NO (yes or no)			
(organization running log)			
(8) how well bottom plugged B.W.V.			
DRILLERS REMARKS:			

DEPT. OF NATURAL RESOURCES  
BUREAU OF LAND & WATER RESOURCES

JUL 12 1984  
RECEIVED

If well telescopes please sketch and show depths.

GROUND LEVEL

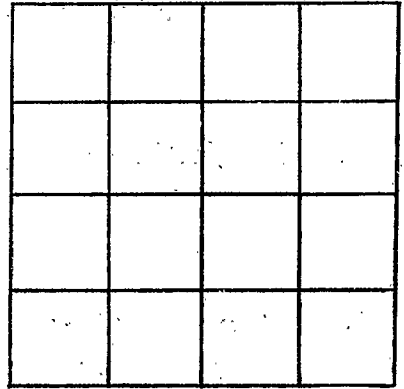

SECTION \_\_\_\_\_

Please indicate well location X.

ADDITIONAL INFORMATION

If more than one screen,  
show locations of each on sketch.