

MISSISSIPPI DEPARTMENT OF NATURAL RESOURCES

Bureau of Land and Water Resources

Southport Mall

P.O. Box 10631

Jackson, Mississippi 39209

WATER WELL DRILLERS LOG

STONE
L
2032

12-13 1984
date well completed

Frank Price
firm name

Stone
county well located

LANDOWNER:

Earl Booker

(mailing address)

WELL LOCATION:

sec. 9 T. 4 N. R. 11 E. S. 5 W. of Henry
2 miles E (distance) (direction) (nearest town)

WELL PURPOSE:

HOME (home, irrigation, municipal, industrial)

WELL COMPLETION DATA:

- (1) diameter (inches) 4"
- (2) total depth (feet) 250'
- (3) static water level (feet) 160' below top of ground.
- (4) casing PVC, 240' (material) (depth)
- (size) if telescope see back.
- (5) screen 10' 240' (length) (depth to top)
- 2" PVC (size) (material)
- (6) pump 1 22 (HP) (yield gpm)
- Elect (type power)
- (7) electric log no (yes or no)

(organization running log)

(8) how well bottom plugged

DRILLERS REMARKS:

description of formations encountered

from to


Top Soil	0	3
Clay	3	12
Coarse Sand	12	24
Clay	24	195
Fine Sand	195	235
Coarse Sand	235	250

7.05
1.25

If well telescopes please sketch and show depths.

24"

GROUND LEVEL

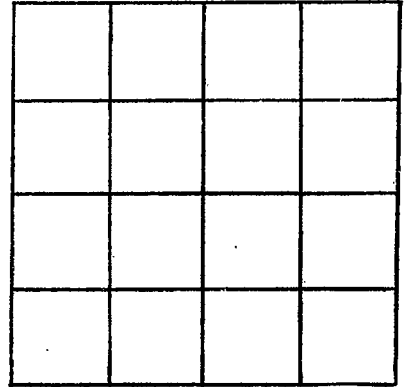

SECTION _____

Please indicate well location X.

ADDITIONAL INFORMATION

A series of horizontal lines for providing additional information.

If more than one screen, show locations of each on sketch.