

MISSISSIPPI DEPARTMENT OF NATURAL RESOURCES

Bureau of Land and Water Resources

Southport Mall

P.O. Box 10631

Jackson, Mississippi 39209

WATER WELL DRILLERS LOG

STONE  
L2034

1-30 date well completed    1986 Parwell Anderson firm name    Stone county well located

LANDOWNER: Kineth Hickman  
Perkinston  
Miss  
(mailing address)

description of formations encountered	from	to
Top Soil	0	2
Clay	2	18
Sand	18	34
Clay	34	42
Sand	42	63

WELL LOCATION:  
sec. 3 T. 4 N. R. 11 E.  
S. W.  
5 miles S-E of Perkinston  
(distance) (direction) (nearest town)

WELL PURPOSE: Home  
(home, irrigation, municipal, industrial)

WELL COMPLETION DATA:

(1) diameter (inches) 2

(2) total depth (feet) 63

(3) static water level (feet) 35 below above top of ground.


(4) casing PVC, 58,  
(material) (depth)  
(size) If telescope see back.

(5) screen 5, 58  
(length) (depth to top)  
2, PVC  
(size) (material)

(6) pump 1, 9  
(HP) (yield gpm)  
Elec  
(type power)

(7) electric log (yes or no)  
(organization running log)

(8) how well bottom plugged Cap

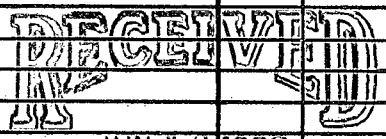


Department of Natural Resources  
Bureau of Land & Water Resources

DRILLERS REMARKS:

If well telescopes please sketch and show depths.

GROUND LEVEL

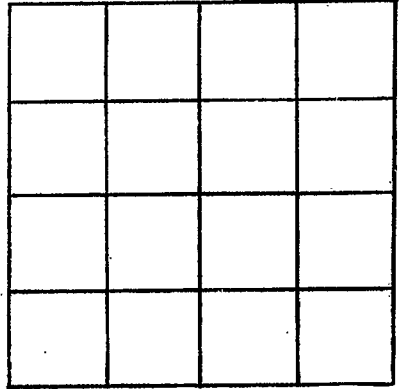

SECTION \_\_\_\_\_

Please indicate well location X.

ADDITIONAL INFORMATION

If more than one screen,  
show locations of each on sketch.