

MISSISSIPPI DEPARTMENT OF ENVIRONMENTAL QUALITY

Office of Land and Water Resources

P. O. Box 10631
Jackson, MS 39289-0631
WATER WELL DRILLERS LOG

COUNTY WELL LOCATED Stone	
WELL NUMBER L	CODED
DATE WELL COMPLETED 2009 3/18/95	

PERMIT NUMBER
NAME OF DRILLING FIRM Moore's Water Well Service
31 R Moore Rd.

NAME & MAILING ADDRESS OF LANDOWNER Rocky Patton			
482 Beaver Dam Rd.			
Perkingston, MS, 39573			
WELL LOCATION:	SEC	TOWNSHIP	RANGE
	9	4 S	11 W
DISTANCE	DIRECTION	NEAREST TOWN	
4 Miles	E	of MS Henry	
OTHER LANDMARK			
WELL PURPOSE: <input checked="" type="checkbox"/> Home, <input type="checkbox"/> Irrigation, <input type="checkbox"/> Municipal, <input type="checkbox"/> Industrial, <input type="checkbox"/> Fish Pond, etc.			

PUMP DATA		
PUMP TYPE (Circle One): Submersible, Turbine, <input checked="" type="checkbox"/> Jet, Flowing Well, Other (Describe) _____		
POWER TYPE (Circle One): <input checked="" type="checkbox"/> Electric, Tractor, Diesel, Gasoline, Butane, Other (Describe) _____ H/P _____		
Pump Capacity (GPM) 4	No. of Stages 3	Setting Depth FT.
PUMP TEST		
Well yielded _____ GPM with a drawdown of _____ ft. after _____ hours of pumping		

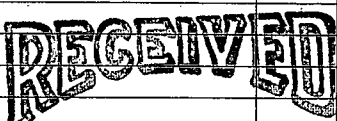
WELL DATA		
Well Depth 240'	Casing Diameter (In.) 2"	Casing Length (Ft.) 220'
Type of Casing PVC	Hole Depth 240'	Depth to Static Water Level 139'
TYPE OF COMPLETION: (Circle One or More): <input checked="" type="checkbox"/> Gravel Packed, <input type="checkbox"/> Underreamed, <input type="checkbox"/> Telescoped, <input checked="" type="checkbox"/> Natural Development, <input type="checkbox"/> Open Hole, <input type="checkbox"/> Other (Describe) _____		

LOG DATA	
TYPE OF LOG RUN (Circle One): No Log Run, Electric, Gamma Ray, Density, Sonic, Neutron, Other (Describe) _____	
Name of Organization Running Log	

WELL GROUTED TO A DEPTH OF **10** FEET
Type Grout (circle one): Cement, Bentonite, or Mix

GEOLOGIC DATA (Office Use Only)			
Surface Elev.	Geologic Unit	Unit Thickness	Depth to Top
Subs. SWL	Date	Analysis	Aquifer Test
Driller's Remarks			

SCREEN DATA		
Diameter - Inches 2"	Length - Feet 20'	Slot Size - Inches .08
Screen Type PVC Sch 40	Depth to Bottom - Feet 240'	

DESCRIPTION OF FORMATIONS ENCOUNTERED	FROM	TO	FORMATIONS (Continued)	FROM	TO
topsoil	0'	2'	 APR 10 1995 Dept. of Environmental Quality Office of Land & Water Resources		
red sandy clay	2'	5'			
Red & White soapstone	5'	40'			
gray soapstone	40'	64'			
Blue soapstone	64'	200'			
coarse sand	200'	240'			

IF MORE SPACE IS NEEDED, USE BACK

If well telescopes please
sketch and show depths.

GROUND LEVEL

SECTION _____

Please indicate well location X.

ADDITIONAL INFORMATION

If more than one screen,
show location of each on sketch.