

Stone  
MI  
11-67

MISSISSIPPI  
BOARD OF WATER COMMISSIONERS  
416 North State Street  
Jackson, Mississippi 39201

7

WATER WELL DRILLERS LOG

11-14-67 date well completed  
19 COAST WATER WELL SERVICE firm name  
STONE county well located

LANDOWNER: SHUMPERT RAMSY  
RAMSY Springs

description of formations encountered	from	to
RED CLAY	0	18
MED SAND	18	68

(mailing address)

WELL LOCATION: NO map  
sec. 17 T 4 N R 9 E  
14 miles E of Mt. Holly  
(distance) (direction) (nearest town)

WELL PURPOSE: HOME  
(home, irrigation, municipal, industrial)

WELL COMPLETION DATA:


- (1) diameter (inches) 2"
- (2) total depth (feet) 68'
- (3) static water level (feet) 35' below top of ground.
- (4) casing GALV, 63' (material) (depth)  
2" if telescope see back. (size)
- (5) screen 5, 63' (length) (depth to top)  
2" PLASTIC (size) (material)
- (6) pump 1/2 (HP) 16 (yield gpm.)  
Elect (type power)
- (7) electric log NO (yes or no)  
(organization running log)
- (8) how well bottom plugged 2" BACK  
WASH VALVE

DRILLERS REMARKS:



If well telescopes please sketch and show depths.

GROUND LEVEL

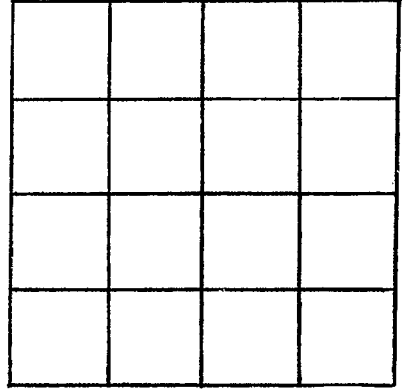

SECTION \_\_\_\_\_

Please indicate well location X:

ADDITIONAL INFORMATION

If more than one screen,  
show locations of each on sketch.