

STONE M

WATER WELL DRILLERS LOG

C. T. SWITZER WELL CO.

Date: 9-23, 1963, Driller:

County Stone

9-23-63

(Name)

(1) Owner of Land: John Williams

(Name)

Stone County

(Address)

(2) Location: 1/4, SE 1/4, Sec. 3 T. 45 R. 9W

(distance) miles (direction) of (Nearest Town)

(3) Topography: (Hilly) (Flat) (Level)

(4) Purpose of Well: Domestic (Domestic Irrigation Municipal, Industrial, Other)

Information upon completion of well:

(1) Diameter 2 inches.

(2) Total Depth 843 feet.

(3) Water Level 104 feet below top of ground.

(4) Cased to 843, Size 2"

(5) Screen: Size 2" Length 101

(6) Were any formations sealed against pollution?

yes, no.

If YES depth of formation


Why North West dip

Drillers Remarks:

Description & Color of Materials Sand, Clay, Red Clay, Shell, etc.

Thickness Feet

Drilled deeper on well drilled 6-13-63
562-569 sand
569-573 mud shales
573-592 sand, fine
592-634 shale & sand shales
634-656 shale rock
656-678 shale small rock
678-692 shale
692-701 sand
701-764 fessers earth
764-777 shale
777-809 shale
small rock
809-844 shale
844-888 sand
888-915

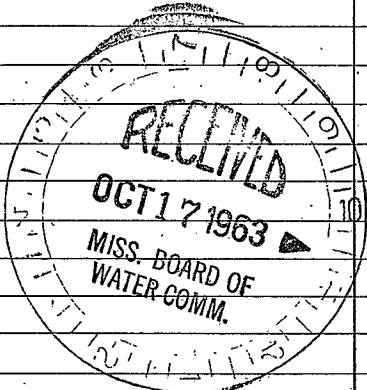

(Use Back Side)

Retain this copy for your office files.

Well No.

100

100

