

MISSISSIPPI  
BOARD OF WATER COMMISSIONERS  
416 North State Street  
Jackson, Mississippi 39201

**CODED**

WATER WELL DRILLERS LOG

STONE
M 3
5-12-71

5-12 19 Farnell Anderson STONE  
date well completed firm name county well located

LANDOWNER: Robt W Omed  
Perkinstan

description of formations encountered

from to

<u>TOP SOIL</u>	<u>0</u>	<u>3</u>
<u>Red Clay</u>	<u>3</u>	<u>19</u>
<u>Fine Sand</u>	<u>19</u>	<u>26</u>
<u>White Clay</u>	<u>26</u>	<u>31</u>
<u>Blue Clay</u>	<u>31</u>	<u>120</u>
<u>Fine Sand</u>	<u>120</u>	<u>136</u>
<u>Blue Clay</u>	<u>136</u>	<u>158</u>
<u>Coarse Sand &amp; Gravel</u>	<u>158</u>	<u>192</u>

(mailing address)

WELL LOCATION:

sec. 17 T. 4 S. R. 10 W.

\_\_\_\_\_ miles \_\_\_\_\_ of \_\_\_\_\_  
(distance) (direction) (nearest town)

WELL PURPOSE: HOME  
(home, irrigation, municipal, industrial)

WELL COMPLETION DATA:

(1) diameter (inches) 2  
(2) total depth (feet) 192  
(3) static water level (feet) 50 below above top of ground.

(4) casing Plastic, 187  
(material) (depth)

\_\_\_\_\_ If telescope see back.  
(size)

(5) screen 5, 187  
(length) (depth to top)

2, Plastic  
(size) (material)

(6) pump 3/4, 8  
(HP) (yield gpm)

ELECT  
(type power)

(7) electric log \_\_\_\_\_  
(yes or no)

\_\_\_\_\_ (organization running log)

(8) how well bottom plugged Backwash Valve

DRILLERS REMARKS:


**CODED**

JUN 3 1971

MISS. BD. OF  
WATER COMM.

If well telescopes please sketch and show depths.

GROUND LEVEL

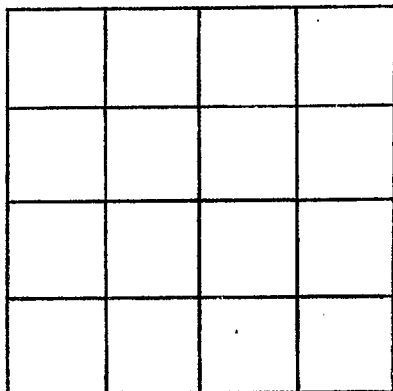

SECTION \_\_\_\_\_

Please indicate well location X.

ADDITIONAL INFORMATION

If more than one screen, show locations of each on sketch.