

STONE
M 4
4-30-70

MISSISSIPPI
BOARD OF WATER COMMISSIONERS
416 North State Street
Jackson, Mississippi 39201

CODED

WATER WELL DRILLERS LOG

4-30 1970 Parnell Anderson Stone
date well completed firm name county well located

LANDOWNER: E.O. Bond
Route 1 Perkinston
(mailing address)

WELL LOCATION:
sec. 9 T 4 S R 10 W
15 miles E of Perkinston
(distance) (direction) (nearest town)

WELL PURPOSE: Home
(home, irrigation, municipal, industrial)

- WELL COMPLETION DATA:
- (1) diameter (inches) 2
 - (2) total depth (feet) 210
 - (3) static water level (feet) 85 below top of ground.
 - (4) casing Plastic, 205 (material) (depth)
 - (size) If telescope see back.
 - (5) screen 5 (length) 205 (depth to top)
 - 2' (size) Plastic (material)
 - (6) pump 1 (HP) 6 (yield gpm)
 - (type power)
 - (7) electric log (yes or no)
 - (organization running log)
 - (8) how well bottom plugged Backwash pipe

description of formations encountered	from	to
TOP SOI	1	3
Red Clay	3	28
Fine Sand	28	35
Blue Clay	33	161
Fine Sand	161	179
Blue Clay	179	186
Fine Sand	186	192
Coarse Sand	192	210

CODED


JUN 11 1970

MISS. BD. OF
WATER COMM.

DRILLERS REMARKS:

If well telescopes please sketch and show depths.

GROUND LEVEL

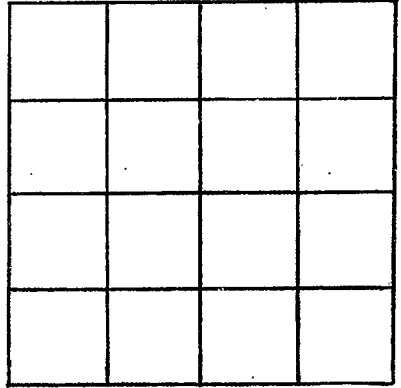

SECTION _____

Please indicate well location X.

ADDITIONAL INFORMATION

If more than one screen, show locations of each on sketch.