

STONE
M6
2-27-74

MISSISSIPPI
BOARD OF WATER COMMISSIONERS
416 North State Street
Jackson, Mississippi 39201

WATER WELL DRILLERS LOG

2-27 1974 Parnell Anderson Stone
date well completed firm name county well located

LANDOWNER:

Jerry Love
Rt 4 Perkinston
(mailing address)

description of formations encountered

from to

Top Soil	0	4
Fine Sand	4	18
White Clay	18	33
Blue Clay	35	148
Fine Sand	148	180
Coarse Sand	180	199

WELL LOCATION:

sec. 17 T. 4 N. R. 10 E. S. 1
14 miles E of Park
(distance) (direction) (nearest town)

WELL PURPOSE: HOME
(home, irrigation, municipal, industrial)

WELL COMPLETION DATA:


- (1) diameter (inches) 2"
- (2) total depth (feet) 199'
- (3) static water level (feet) 63' below top of ground.
- (4) casing Plastic, 194' (material) (depth)
- (size) If telescope see back.
- (5) screen 5' 194' (length) (depth to top)
- 2" Plastic (size) (material)
- (6) pump 1 7 (HP) (yield gpm)
- Elect (type power)
- (7) electric log no (yes or no)

CODED

(organization running log)

(8) how well bottom plugged Back wash valve

DRILLERS REMARKS:

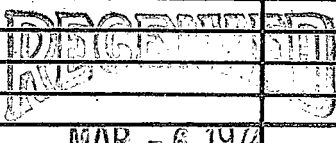


MAR - 6 1974

MISS. BD. OF WATER COMMISSIONERS

If well telescopes please sketch and show depths.

GROUND LEVEL

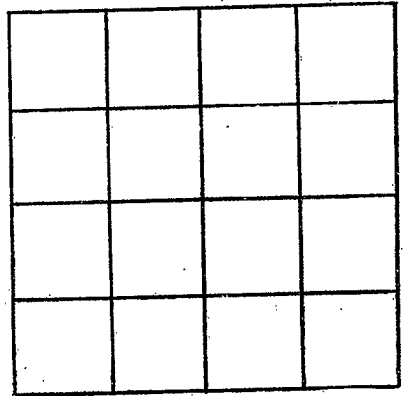

SECTION _____

Please indicate well location X.

ADDITIONAL INFORMATION

If more than one screen,
show locations of each on sketch.