

STONE  
M9  
6-19-74

MISSISSIPPI  
BOARD OF WATER COMMISSIONERS  
416 North State Street  
Jackson, Mississippi 39201

CODED

WATER WELL DRILLERS LOG

6-19 1974  
date well completed

Parva Landers  
firm name

Stone  
county well located

LANDOWNER:

Thomas J. Bond  
Rt 1 Durkinston  
(mailing address)

description of formations encountered

description of formations encountered	from	to
Top Soil	0	4
Red Clay	4	14
Sandy Clay	14	28
Fine Sand	28	105
Coarse Sand	105	124

WELL LOCATION:

sec 21 T 4 S R 9 W  
18 miles SE of Park  
(distance) (direction) (nearest town)

WELL PURPOSE: HOME  
(home, irrigation, municipal, industrial)

WELL COMPLETION DATA:

- (1) diameter (inches) 2"
- (2) total depth (feet) 124'
- (3) static water level (feet) 29' below top of ground
- (4) casing Plastic, 119' (material) (depth)
- (size) If telescope see back.
- (5) screen 5' length, 119' depth to top
- (size) 2 Plastic (material)
- (6) pump 1 HP, 10 yield gpm
- (type power) Elect
- (7) electric log no (yes or no)

CODED

(organization running log)

(8) how well bottom plugged Back water valve


DRILLERS REMARKS:

RECEIVED

JUL - 5 1974

If well telescopes please sketch and show depths.

GROUND LEVEL

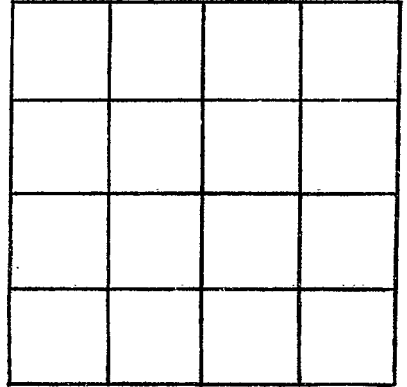

SECTION \_\_\_\_\_

Please indicate well location X.

ADDITIONAL INFORMATION

If more than one screen,  
show locations of each on sketch.