

STONE  
M 10  
6-18-74

MISSISSIPPI  
BOARD OF WATER COMMISSIONERS  
416 North State Street  
Jackson, Mississippi 39201

CODED

WATER WELL DRILLERS LOG

6-18 1974 Danell Anderson Stone  
date well completed firm name county well located

LANDOWNER:

Vernon Ledner  
Rt 1 Perkinston  
(mailing address)

description of formations encountered

from to

Top Soil 0 4  
Pink Clay 4 19  
Fine Sand 19 45  
Coarse sand 45 65

WELL LOCATION:

sec. 6 T. 4 S. R. 10 E.  
14 miles E of Perk  
(distance) (direction) (nearest town)

WELL PURPOSE: HOME  
(home, irrigation, municipal, industrial)

WELL COMPLETION DATA:

- (1) diameter (inches) 2"
- (2) total depth (feet) 65'
- (3) static water level (feet) 34' below top of ground.
- (4) casing Plastic 150'  
(material) (depth)
- \_\_\_\_\_ if telescope see back.  
(size)
- (5) screen 5' 60'  
(length) (depth to top)
- 2" Plastic  
(size) (material)
- (6) pump 1 9  
(HP) (yield gpm)
- Elect  
(type power)
- (7) electric log no  
(yes or no)

CODED

(organization running log)


(8) how well bottom plugged  
Plugged

DRILLERS REMARKS:

RECEIVED  
JUL - 5 1974

If well telescopes please sketch and show depths.

GROUND LEVEL

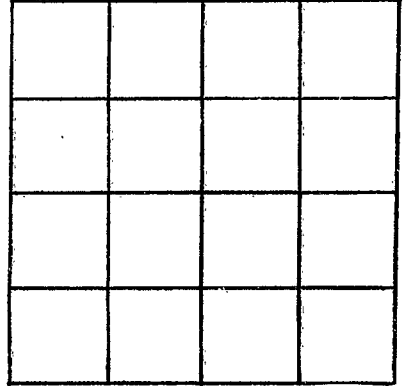

SECTION \_\_\_\_\_

Please indicate well location X.

ADDITIONAL INFORMATION

If more than one screen,  
show locations of each on sketch.