County: <u>Stope</u> Permit #: Driller(<u>CASHWAter WellSRV</u> Date drilling completed: <u>4733-07</u> Hississippi Departmen Office of Land a P.O. I Jackson, N (601) (601)35	Part 1 Part 1 Mississippi Department of Environmental Quality Office of Land and Water Resources P.O. Box 10631 Jackson, MS 39289-0631 (601)961-5210 (601)354-6938 (fax) quires that this report be prepared by the driller in detail and filed wi mpletion of drilling of the well.			
		Location		
Owner Name Jaime Lizana Mailing Address: EAST MCHENry Rd.	Latitude: <u>20°41'17</u> 43 Method of Lat/Long (circle or	" Longitude <u>8.58</u> .08" 0.5		
Dealine to a Ma 22 - art		GPS, Survey-grade GPS		
Perkinston IIIS 39579 City State Zip Code		Twn THS Rng R10W		
Telephone No. 228 818 - 0180	Distance Direction	Nearest Town of <u>MEHEWRY</u>		
Well Data				
Purpose of Well (circle one) (Home) Industrial Public Supply Irrigation Fish Culture Other:				
Date well drilling started: 433-07 Date well drilling completed: 433-07				
If flowing, method of flow regulation: Valve N/A Other (describe)				
Static Water Level: 70 feet above or below circle one) land surface Date measured: 4-23-07				
Method of Measurement (circle one) steel tape electric tape air line other:				
Hole depth: <u>200FT</u> Well depth: <u>200FT</u> Well grouted to a depth offeet				
Type of grout (circle one): Cement Bentonite Mix				
Casing length: 210_feet Casing diameter: inches Type of casing:				
Screen length: $\underline{\bigcirc}$ feet Screen diameter: $\underline{\bigcirc}$ inches Type of screen: $\underline{\frown}$				
Screen slot size: <u>•008</u> inches Setting depth: From <u>210</u> feet to <u>220</u> feet				
Type of completion (circle all applicable): Gravel packed Underreamed Telescoped Open hole Natural Development				
Other (describe):				
Top of lap pipe or reduction in casing: _N/Afeet. If telescoped or more than one screen, describe on back of page				
Logs run (circle all applicable): No log run Electric Gamma Ray Density Sonic Neutron Other:				
Name of organization running log(s): N/A				
I certify that the well was drilled, constructed, and completed in accordance with all applicable requirements of the Mississippi				
Department of Environmental Quality and/or the Mississippi Department of Health regulations and state laws.				
Jack Ridgdell 0-472	_ Sait 1	aldella		
Print Name of Water Well Contractor and License No.	Signature of W	Vater Well Contractor		
		MAY 2 + 2007		

•

.....

BY: OLWE


M-52

If well telescopes please sketch below and show depths.

Ground Level

Description of Formations Encountered TOPSOIL Orange, Clay Brown Coarse Sand BILLE, Clay Gray Coarse, Sand	From To 0 2 3 37 3754 54 150 150 200

If more than one screen, show location of each on sketch

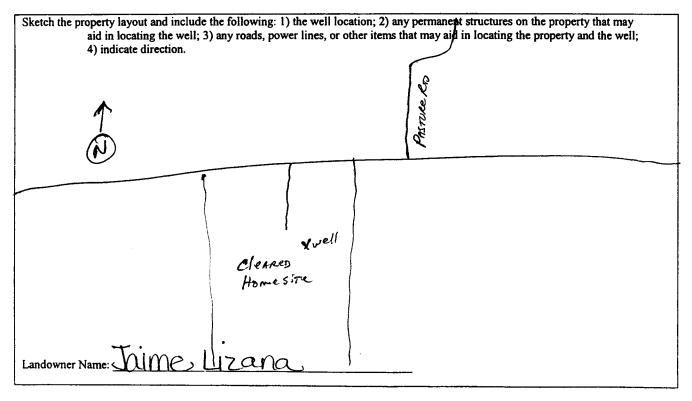

Sell Signature of Water Well Contractor

MAY 2 1 2007 BY: OLWR

RECEIVED