

State Well Report

Part 1

Mississippi Department of Environmental Quality
Office of Land and Water Resources
P.O. Box 10631
Jackson, MS 39289-0631
(601)961-5210
(601)354-6938 (fax)

For Office Use Only:

Aquifer: _____
Well #: M-57
L. S. Elevation: _____
E-log #: _____

County: Stone
Permit #: _____
Driller: John W Thompson
Date drilling completed: 5-21-07

State Law requires that this report be prepared by the driller in detail and filed with the Department within 30 days of completion of drilling of the well.

Well Owner Information		Well Location	
Owner Name: <u>Comstock</u>	Latitude: _____ Longitude: _____	Method of Lat/Long (circle one): Conventional Survey, USGS quad, Hand-held GPS, Survey-grade GPS	
Mailing Address: <u>2000 Hwy 842</u> <u>Laurel MS 39441</u>	_____ 1/4 _____ 1/4 Sec <u>4</u> Twn <u>45</u> Rng <u>102</u>		
City _____ State _____ Zip Code _____	Distance _____ Miles	Direction <u>SE</u>	Nearest Town <u>Wiggins</u>
Telephone No. (____) _____			
Well Data			
Purpose of Well (circle one) Home Industrial Public Supply Irrigation Fish Culture Other: <u>rig supply</u>			
Date well drilling started: <u>5-21-07</u>		Date well drilling completed: <u>5-21-07</u>	
If flowing, method of flow regulation: Valve _____ Other (describe) _____			
Static Water Level: <u>89</u> feet above or below (circle one) land surface		Date measured: <u>5-21-07</u>	
Method of Measurement (circle one) steel tape <u>electric tape</u> air line other: _____			
Hole depth: <u>190</u>	Well depth: <u>170</u>	Well grouted to a depth of <u>20</u> feet	
Type of grout (circle one): Cement <u>Bentonite</u> Mix			
Casing length: <u>130</u> feet	Casing diameter: <u>4</u> inches	Type of casing: <u>PVC</u>	
Screen length: <u>40</u> feet	Screen diameter: <u>4</u> inches	Type of screen: <u>PVC Slotted</u>	
Screen slot size: <u>.010 + .020</u> inches Setting depth: From <u>130-150</u> feet to <u>150-170</u> feet			
Type of completion (circle all applicable): Gravel packed Underreamed Telescoped Open hole <u>Natural Development</u>			
Other (describe): _____			
Top of lap pipe or reduction in casing: _____ feet. If telescoped or more than one screen, describe on back of page			
Logs run (circle all applicable): <u>No log run</u> Electric Gamma Ray Density Sonic Neutron Other: _____			
Name of organization running log(s): _____			
I certify that the well was drilled, constructed, and completed in accordance with all applicable requirements of the Mississippi Department of Environmental Quality and/or the Mississippi Department of Health regulations and state laws.			
<u>John W Thompson</u> <u>0-679</u>		<u>John W Thompson</u>	
Print Name of Water Well Contractor and License No.		Signature of Water Well Contractor	

RECEIVED

JUN 21 2007


BY OLWF

Signature of Water Well Contractor

John H. Thompson

Landowner Name:

Constock

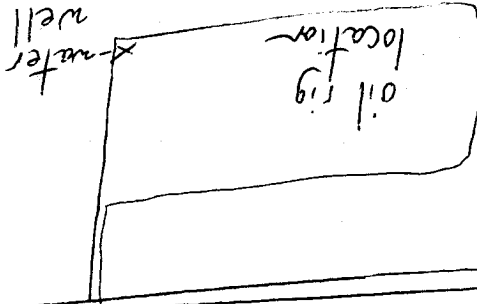

Wire Rd


Sketch the property layout and include the following: 1) the well location; 2) any permanent structures on the property that may aid in locating the well; 3) any roads, power lines, or other items that may aid in locating the property and the well; 4) indicate direction.

Ignore more than one screen, show location of each on sketch

Description of Formations Encountered		From	To
Clay		0	10
sand		10	18
blue clay		18	80
clay & sand strips		80	160
good sand		160	170
clay		170	190

If well telescopes please sketch below and show depths.

Ground Level

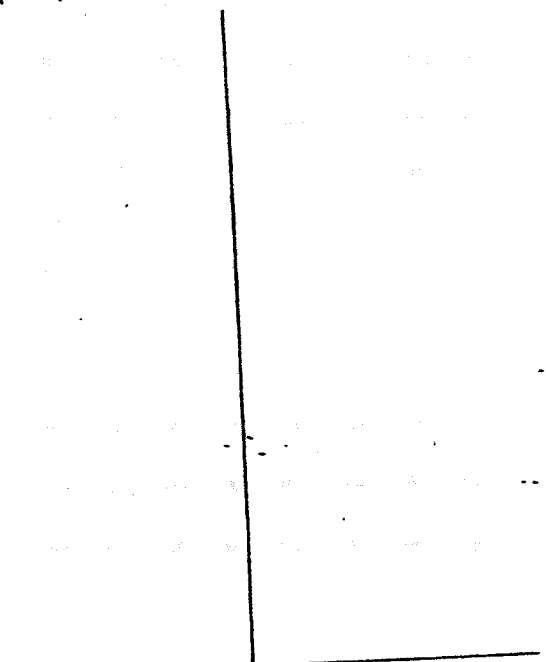

STATE WELL REPORT

Part 2

Pump Installer's Completion Report
Mississippi Department of Environmental Quality
Office of Land and Water Resources
P.O. Box 10631
Jackson, MS 39289-0631
(601)961-5210
(601)354-6938 (fax)

County Stone
Permit #:
Driller: John W Thompson
Date completed: 5-21-07

For Office Use Only:

Aquifer:
Well #: M-57
Elevation:

This report should be prepared by the pump installer in detail and filed with the Department within 30 days of the installation of pump.

Well Owner Information	Well Location
Owner Name: <u>Constock</u>	Latitude: _____ Longitude: _____
Mailing Address: <u>2000 Hwy 84 W</u> <u>Laurel MS</u>	Method of Lat/Long (circle one): Conventional Survey, USGS quad, Hand-held GPS, Survey-grade GPS
City _____ State _____ Zip Code _____	_____ 1/4 _____ 1/4 Sec <u>4</u> Twn <u>4S</u> Rng <u>10W</u>
Telephone No. () _____	Distance _____ Direction _____ Nearest Town _____
	<u>12</u> Miles <u>SE</u> of <u>Wiggins</u>

Pump Type Circle one	Power Type Circle one
<input type="checkbox"/> Air Lift <input type="checkbox"/> Jet <input checked="" type="checkbox"/> <u>Submersible</u> <input type="checkbox"/> Bucket <input type="checkbox"/> Piston <input type="checkbox"/> Turbine <input type="checkbox"/> Centrifugal <input type="checkbox"/> Rotary <input type="checkbox"/> Flowing Well Other (specify): _____	<input type="checkbox"/> Diesel Engine <input type="checkbox"/> Gasoline Engine <input type="checkbox"/> Natural Gas <input checked="" type="checkbox"/> <u>Electric Motor</u> <input type="checkbox"/> Hand <input type="checkbox"/> Tractor PTO <input type="checkbox"/> Windmill Other (specify): _____ Horse Power Rating of Motor: <u>5</u> Setting Depth: <u>120</u> feet Number of Stages: _____
Date Pump Installed: <u>5-21-07</u>	
Rated Pump Capacity: <u>55</u> Gallons Per Minute	

Pump Test Data	Method of Measuring Water Level Circle one
Date Well Tested: <u>5-21-07</u>	<input type="checkbox"/> Air Line <input checked="" type="checkbox"/> <u>Electric Measuring Line</u> <input type="checkbox"/> Steel Tape Other (specify): _____
Static Water Level (A): <u>89</u> Feet Below Land Surface	For flowing well, measured shut in head: _____ feet
Pumping Water Level (B): <u>96</u> Feet Below Land Surface	Well yielded <u>50</u> GPM with a drawdown of
Drawdown ((B) - (A)): <u>7</u> Feet Below Land Surface	<u>7</u> feet after <u>4</u> hours of pumping
Test Pumping Rate: <u>50</u> Gallons Per Minute	
Duration of Pump Test (minimum 4 hours): _____ hours	

I HEREBY CERTIFY that the above statements are true to the best of my knowledge.

John W Thompson 0-679 John W Thompson
Print Name of Pump Installer and License No. (if applicable) Signature of Pump Installer

RECEIVED
JUN 01 2007
BY: OLWR