

# State Well Report

## Part 1

Mississippi Department of Environmental Quality  
Office of Land and Water Resources  
P.O. Box 10631  
Jackson, MS 39289-0631  
(601) 961-5210  
(601) 354-6938 (fax)

**For Office Use Only:**

Aquifer: \_\_\_\_\_  
Well #: M190  
L. S. Elevation: \_\_\_\_\_  
E-log #: \_\_\_\_\_

County: Stone  
Permit #: \_\_\_\_\_  
Driller: Coast Water Wells SRV  
Date drilling completed: 3/5/13

**State Law requires that this report be prepared by the driller in detail and filed with the Department within 30 days of completion of drilling of the well.**

Well Owner Information	Well Location
Owner Name: <u>Darryl Sumrall</u>	Latitude: <u>30° 41' 51.00"</u> Longitude: <u>88° 57' 55.56"</u>
Mailing Address: <u>2071 East McHenry Road</u>	Method of Lat/Long (circle one): Conventional Survey, USGS quad, <u>Hand-held GPS</u> , Survey-grade GPS
<u>Perkinston, MS 39573</u>	SE 1/4 NW 1/4 Sec <u>18</u> Twn <u>T45</u> Rng <u>R10W</u>
City State Zip Code	NW SW 14
Telephone No.: <u>(228) 806-3400</u>	Distance Direction Nearest Town
	<u>10 1/2</u> Miles <u>SE</u> of <u>Perkinston</u>

**Well Data**

Purpose of Well (circle one) Home Industrial Public Supply Irrigation Fish Culture Other: \_\_\_\_\_

Date well drilling started: 3/5/13 Date well drilling completed: 3/5/13

If flowing, method of flow regulation: Valve N/A Other (describe) \_\_\_\_\_

Static Water Level: 85 feet above or below (circle one) land surface Date measured: 3/5/13

Method of Measurement (circle one) steel tape electric tape air line other: \_\_\_\_\_

Hole depth: 190 FT Well depth: 190 FT. Well grouted to a depth of 10 feet

Type of grout (circle one): Cement Bentonite Mix

Casing length: 175 feet Casing diameter: 2 inches Type of casing: PVC

Screen length: 15 feet Screen diameter: 2 inches Type of screen: PVC

Screen slot size: 004 inches Setting depth: From 175 feet to 190 feet

Type of completion (circle all applicable): Gravel packed Underreamed Telescoped Open hole Natural Development

Other (describe): \_\_\_\_\_

Top of lap pipe or reduction in casing: N/A feet. If telescoped or more than one screen, describe on back of page

Logs run (circle all applicable): No log run Electric Gamma Ray Density Sonic Neutron Other: \_\_\_\_\_

Name of organization running log(s): N/A

I certify that the well was drilled, constructed, and completed in accordance with all applicable requirements of the Mississippi Department of Environmental Quality and/or the Mississippi Department of Health regulations and state laws.

Jack Ridgdell 0-472  
Print Name of Water Well Contractor and License No.

Jack Ridgdell  
Signature of Water Well Contractor

RECEIVED  
MAR 28 2013  
BY: [Signature]

If well telescopes please sketch below and show depths.


Ground Level

A large empty rectangular box for sketching well telescopes and depths.

Description of Formations Encountered	From	To
Top soil	0	2
Orange clay	2	115
Gray medium sand	115	130
Blue clay	130	165
Gray medium sand	165	190

If more than one screen, show location of each on sketch

Sketch the property layout and include the following: 1) the well location; 2) any permanent structures on the property that may aid in locating the well; 3) any roads, power lines, or other items that may aid in locating the property and the well; 4) indicate direction.

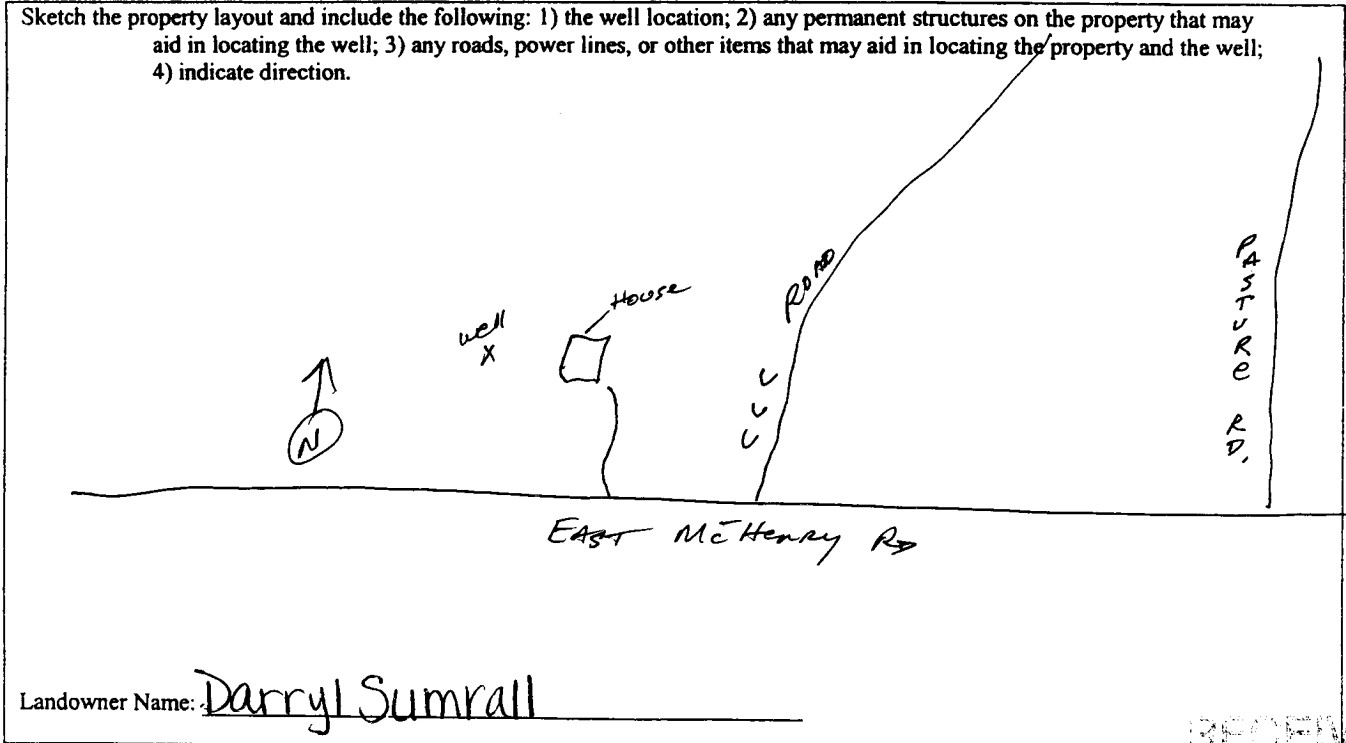

Landowner Name: Darryl Sumrall

RECEIVED

MAR 18 2013

BY: OLWR

[Handwritten Signature]  
Signature of Water Well Contractor

# STATE WELL REPORT

## Part 2

**Pump Installer's Completion Report**  
 Mississippi Department of Environmental Quality  
 Office of Land and Water Resources  
 P.O. Box 10631  
 Jackson, MS 39289-0631  
 (601) 961-5210  
 (601) 354-6938 (fax)

County: Stone  
 Permit #: \_\_\_\_\_  
 Driller: Coast Water Wells SRV.  
 Date completed: 3/5/13

**For Office Use Only:**

Aquifer: \_\_\_\_\_  
 Well #: M90  
 Elevation: \_\_\_\_\_

**This report should be prepared by the pump installer in detail and filed with the Department within 30 days of the installation of pump.**

Well Owner Information	Well Location
Owner Name: <u>Darryl Sumrall</u>	Latitude: <u>30°41'51.60"</u> Longitude: <u>088°57'55.56"</u>
Mailing Address: <u>2071 East McHenry Road</u>	Method of Lat/Long (circle one): Conventional Survey,
<u>Perkinston, MS 39573</u>	USGS quad, <u>(Hand-held GPS)</u> Survey-grade GPS
City State Zip Code	<u>SE</u> 1/4 <u>NW</u> 1/4 Sec <u>15</u> Twn <u>T45</u> Rng <u>R10W</u>
Telephone No. ( ) _____	<u>NW</u> <u>SW</u> <u>14</u>
	Distance Direction Nearest Town
	<u>10 1/2</u> Miles <u>SE</u> of <u>Perkinston</u>

Pump Type Circle one	Power Type Circle one
Air Lift <input type="radio"/> <u>Jet</u> <input type="radio"/> Submersible	Diesel Engine Gasoline Engine Natural Gas
Bucket <input type="radio"/> Piston <input type="radio"/> Turbine	<u>Electric Motor</u> <input type="radio"/> Hand <input type="radio"/> Tractor PTO
Centrifugal <input type="radio"/> Rotary <input type="radio"/> Flowing Well	Windmill Other (specify): _____
Other (specify): _____	Horse Power Rating of Motor: <u>2 H.P.</u>
Date Pump Installed: <u>3/6/13</u>	Setting Depth: <u>100 FT. Drop Pipe</u> feet
Rated Pump Capacity: <u>10</u> Gallons Per Minute	Number of Stages: <u>3</u>

Pump Test Data	Method of Measuring Water Level Circle one
Date Well Tested: <u>3/6/13</u>	<u>Air Line</u> <input type="radio"/> Electric Measuring Line <input type="radio"/> Steel Tape <input type="radio"/>
Static Water Level (A): <u>85</u> Feet Below Land Surface	Other (specify): _____
Pumping Water Level (B): <u>N/A</u> Feet Below Land Surface	For flowing well, measured shut in head: <u>N/A</u> feet
Drawdown [(B) - (A)]: <u>N/A</u> Feet Below Land Surface	Well yielded <u>16</u> GPM with a drawdown of
Test Pumping Rate: <u>10</u> Gallons Per Minute	<u>N/A</u> feet after <u>N/A</u> hours of pumping
Duration of Pump Test (minimum 4 hours): <u>5 1/2</u> hours	

I HEREBY CERTIFY that the above statements are true to the best of my knowledge.

Jack Ridgell 0-472 Jack Ridgell  
 Print Name of Pump Installer and License No. (if applicable) Signature of Pump Installer