

STONE
 M 2004
 3-12-76

MISSISSIPPI
 BOARD OF WATER COMMISSIONERS
 416 North State Street
 Jackson, Mississippi 39201

WATER WELL DRILLERS LOG

3-12 date well completed 1976 M&B Drilling Co. firm name Stone county well located

LANDOWNER:
 W. C. Dollakite
 10 Keyser Lane - Gulfport, Miss.
 (mailing address)

WELL LOCATION:
 sec. 5 T 4 N R 9 E
 S W
 13 miles E of McHenry
 (distance) (direction) (nearest town)

WELL PURPOSE: Private
 (home, irrigation, municipal, industrial)

- WELL COMPLETION DATA:
- (1) diameter (inches) 4" x 2"
 - (2) total depth (feet) 610 FT
 - (3) static water level (feet) 115 below above top of ground.
 - (4) casing PVC 600
 (material) (depth)
4" x 2 if telescope see back.
 (size)
 - (5) screen 3" - 1/4" - Ice Back
 (length) (depth to top)
2" PVC
 (size) (material)
 - (6) pump 3 35
 (HP) (yield gpm)
2200 1/2
 (type power)
 - (7) electric log No
 (yes or no)

(organization running log)

(8) how well bottom plugged 2" back wash valve

description of formations encountered	from	to
Red Clay	0	30
Sand	30	100
Sand & Gravel	100	105
Sand	105	120
Blue Clay	120	205
Sand	205	225
Blue Clay	225	230
Sand	230	260
Blue Clay	260	285
Sand	285	300
Blue Clay	300	360
Blue Clay Limestone layers	360	370
Blue Clay	370	570
Sand	570	605
Blue Clay	605	610+


APR 19 1976

DRILLERS REMARKS:

MISS. BD. OF WATER COMMISSIONERS

If well telescopes please sketch and show depths.

GROUND LEVEL

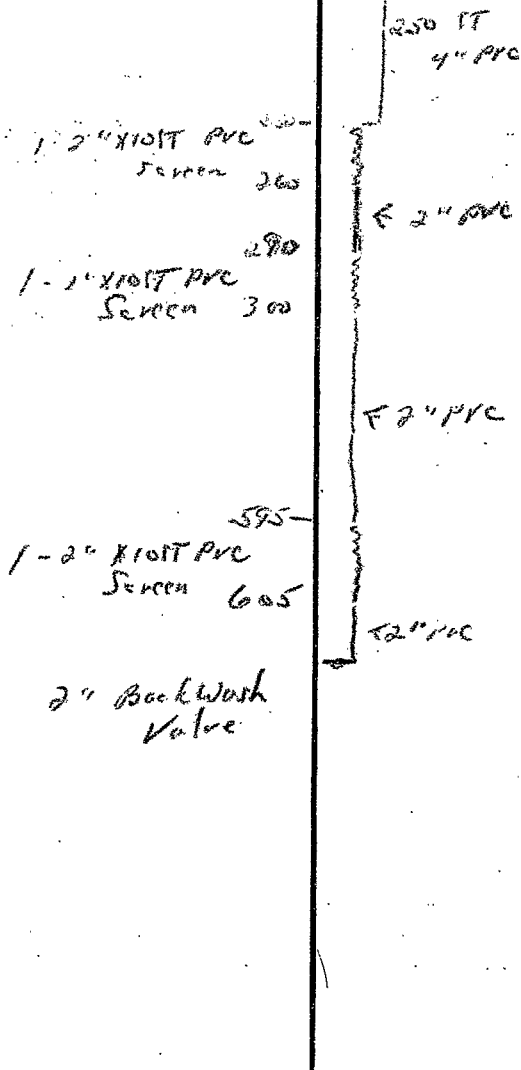

	X		

SECTION 5

Please indicate well location X.

ADDITIONAL INFORMATION

If more than one screen, show locations of each on sketch.