

Stone
 M 2002
 8/31/77

MISSISSIPPI
 BOARD OF WATER COMMISSIONERS
 416 North State Street
 135 Jackson, Mississippi 39201


WATER WELL DRILLERS LOG

8-31 1977 Arnold Anderson Stone
 date well completed firm name county well located

LANDOWNER:	description of formations encountered	from	to
<u>Chester Diaz</u> (mailing address)	<u>Top Soil</u>	0	3
WELL LOCATION: sec. <u>5</u> T. <u>4</u> N. R. <u>9</u> E <u>15</u> miles <u>SE</u> of <u>Park</u> (distance) (direction) (nearest town)	<u>Red Clay</u>	3	32
WELL PURPOSE: <u>HOME</u> (home, irrigation, municipal, industrial)	<u>Sandy Clay</u>	32	118
WELL COMPLETION DATA: (1) diameter (inches) <u>2"</u> (2) total depth (feet) <u>127'</u> (3) static water level (feet) <u>38'</u> below top of ground (4) casing <u>Plastic</u> <u>127'</u> (material) (depth) (size) if telescope see back. (5) screen <u>5'</u> <u>127'</u> (length) (depth to top) <u>2"</u> <u>Plastic</u> (size) (material) (6) pump <u>1</u> <u>10</u> (HP) (yield gpm) <u>Elect</u> (type power) (7) electric log <u>no</u> (yes or no) (organization running log) (8) how well bottom plugged <u>cap</u>	<u>Coarse Sand</u>	118	127
DRILLERS REMARKS:	<div data-bbox="680 1446 1029 1647" data-label="Text"> <p>RECEIVED SEP - 2 1977 MISS. Bd. OF WATER COMMISSIONERS</p> </div>		

If well telescopes please sketch and show depths.

GROUND LEVEL

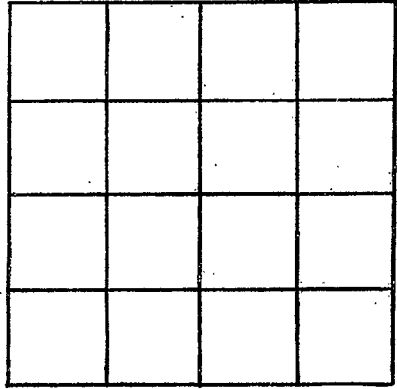

SECTION _____

Please indicate well location X.

ADDITIONAL INFORMATION

If more than one screen, show locations of each on sketch.