

Stone
 M 2003
 9/1/77

MISSISSIPPI
 BOARD OF WATER COMMISSIONERS
 416 North State Street
 Jackson, Mississippi 39201

WATER WELL DRILLERS LOG

9-1 1977 Parne Anderson Stone
 date well completed firm name county well located

LANDOWNER: Head Hunters Club
 (mailing address)


description of formations encountered	from	to
<u>Topsoil</u>	<u>0</u>	<u>2</u>
<u>Red Clay</u>	<u>2</u>	<u>17</u>
<u>Column Sand</u>	<u>17</u>	<u>83</u>

WELL LOCATION:
 sec 37 T 4 S R 9 W
15 miles SE of Perk
 (distance) (direction) (nearest town)

WELL PURPOSE: ADMI
 (home, irrigation, municipal, industrial)

- WELL COMPLETION DATA:
- (1) diameter (inches) 2"
 - (2) total depth (feet) 83
 - (3) static water level (feet) 44' below top of ground.
 - (4) casing Plastic, 78'
 (material) (depth)
 (size) If telescope see back.
 - (5) screen 5', 78'
 (length) (depth to top)
2" Plastic
 (size) (material)
 - (6) pump 1 (HP) 10 (yield gpm)
Elect
 (type power)
 - (7) electric log no
 (yes or no)
 - (organization running log)
 - (8) how well bottom plugged Capped

DRILLERS REMARKS:

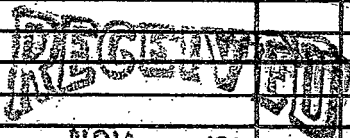


NOV - 8 1977

MISS. BD. OF WATER COMM

If well telescopes please sketch and show depths.

GROUND LEVEL

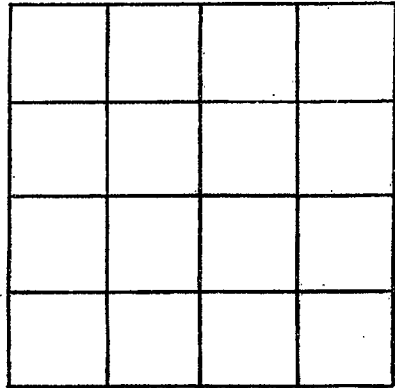

SECTION _____

Please indicate well location X.

ADDITIONAL INFORMATION

If more than one screen, show locations of each on sketch.