

MISSISSIPPI
BOARD OF WATER COMMISSIONERS
416 North State Street
Jackson, Mississippi 39201

WATER WELL DRILLERS LOG

Stone
M 2004
11-3-79

11-3 date well completed 1979 Braden Pump + Well Service, Inc firm name Stone county well located

LANDOWNER:
Vincent Carroll
Rt. 1, Box 14612
Biloxi, MS 39532
(mailing address)

description of formations encountered	from	to
Clay	0	20
Clay	20	35
Sand	35	80

WELL LOCATION:
sec 20 T 4 S R 9 E
5 miles S of Amory
(distance) (direction) (nearest town)

WELL PURPOSE: Camp
(home, irrigation, municipal, industrial)

- WELL COMPLETION DATA:
- (1) diameter (inches) 2"
 - (2) total depth (feet) 80'
 - (3) static water level (feet) 18' below top of ground.
 - (4) casing PVC (material) total (depth)
2" (size) If telescope see back.
 - (5) screen 5' (length) 75' (depth to top)
2" (size) PVC (material)
 - (6) pump 1/2 (HP) 10 (yield gpm)
AOV (type power)
 - (7) electric log no (yes or no)
- (organization running log)
- (8) how well bottom plugged 2" sand shark

DEPT. OF NATURAL RESOURCES
BUREAU OF LAND & WATER RESOURCES


JAN 14 1980

DRILLERS REMARKS:
No tail pipe

RECEIVED

If well telescopes please sketch and show depths.

GROUND LEVEL

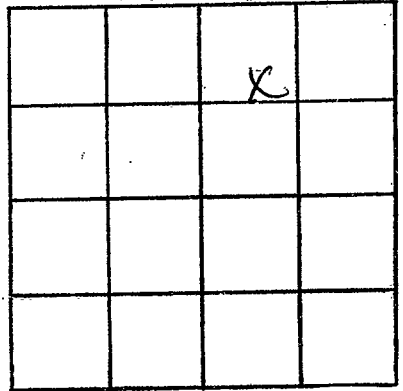

SECTION 20

Please indicate well location X.

ADDITIONAL INFORMATION

If more than one screen,
show locations of each on sketch.