

MISSISSIPPI DEPARTMENT OF NATURAL RESOURCES

Bureau of Land and Water Resources

Southport Mall

P.O. Box 10631

Jackson, Mississippi 39209

WATER WELL DRILLERS LOG

M 2005  
STONE  
2-11-85

2-11  
date well completed

1985 - J. Tom Price  
firm name

Stone  
county well located

LANDOWNER:  
John Whittle  
(mailing address)

WELL LOCATION:  
sec. 17 T 4 R 9  
1 MILE N of Harrison County  
miles direction of line  
(distance) (direction) (nearest town)

WELL PURPOSE: HOME  
(home, irrigation, municipal, industrial)

WELL COMPLETION DATA:

(1) diameter (inches) 2"

(2) total depth (feet) 137'

(3) static water level (feet) 20' below top of ground.

(4) casing PVC 132'  
(material) (depth)  
(size) if telescope see back.

(5) screen 5' 132'  
(length) (depth to top)  
2' PVC  
(size) (material)

(6) pump 1 10  
(HP) (yield gpm)  
Elect  
(type power)

(7) electric log no  
(yes or no)  
(organization running log)

(8) how well bottom plugged  
B W V

description of formations encountered	from	to
Top Soil	0	2
Red Clay	2	12
Blue Clay	12	114
Coarse Sand	114	137


RECEIVED  
APR 27 1985

Department of Natural Resources  
Bureau of Land & Water Resources

DRILLERS REMARKS:

If well telescopes please sketch and show depths.

GROUND LEVEL

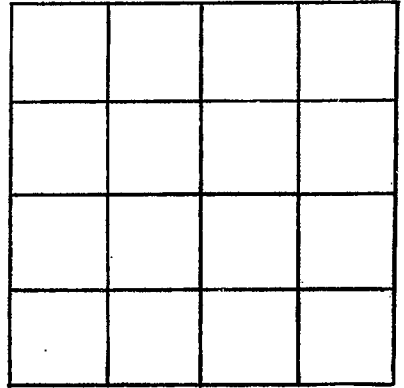

SECTION \_\_\_\_\_

Please indicate well location X.

ADDITIONAL INFORMATION

If more than one screen, show locations of each on sketch.