

MISSISSIPPI DEPARTMENT OF NATURAL RESOURCES

Bureau of Land and Water Resources

Southport Mall

P.O. Box 10631

Jackson, Mississippi 39209

WATER WELL DRILLERS LOG

STONE  
Macon

2-14

1980 Parwell Anderson

Stone

date well completed

firm name

county well located

LANDOWNER: Chester Diaz

Perkinston Miss

(mailing address)

description of formations encountered

from to

Top Soil	0	2
Clay	2	15
Sand	15	28
Clay	28	54
Sand	54	73

WELL LOCATION:

sec. 4 T. 4 S R. 9 W  
16 miles E of Perkinston  
(distance) (direction) (nearest town)

WELL PURPOSE: Home  
(home, irrigation, municipal, industrial)


WELL COMPLETION DATA:

- (1) diameter (inches) 2
- (2) total depth (feet) 78
- (3) static water level (feet) 45 below top of ground.
- (4) casing PVC, 73  
(material) (depth)
- (size) if telescope see back.
- (5) screen 5, 73  
(length) (depth to top)
- 2, PVC  
(size) (material)
- (6) pump 1, 10  
(HP) (yield gpm)
- Electric  
(type power)
- (7) electric log No  
(yes or no)

(organization running log)

(8) how well bottom plugged Cap

DRILLERS REMARKS:

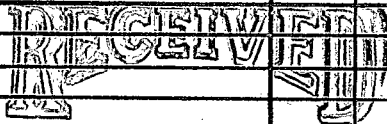


JUN 12 1985

Department of Natural Resources  
Bureau of Land & Water

If well telescopes please sketch and show depths.

GROUND LEVEL

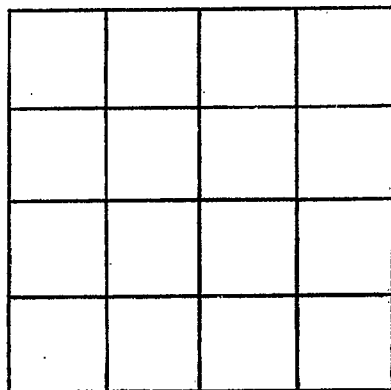

SECTION \_\_\_\_\_

Please indicate well location X.

ADDITIONAL INFORMATION

If more than one screen,  
show locations of each on sketch.