

MISSISSIPPI DEPARTMENT OF NATURAL RESOURCES

Bureau of Land and Water Resources

Southport Mall

P.O. Box 10631

Jackson, Mississippi 39209

WATER WELL DRILLERS LOG

STONE
MASSON

14-74 date well completed 1986 Barwell Anderson firm name STONE county well located

LANDOWNER: Everett Farve
Perkinston
Miss
(mailing address)

description of formations encountered	from	to
Top Soil	0	2
Clay	2	17
Sand	17	28
Blue Clay	28	168
Sand	168	174
Clay	174	189
Sand	189	230

WELL LOCATION:
sec. 13 T. 4 N. R. 10 E
S W
1.5 miles S-E of Perkinston
(distance) (direction) (nearest town)

WELL PURPOSE: Home
(home, irrigation, municipal, industrial)

WELL COMPLETION DATA:

(1) diameter (inches) 2

(2) total depth (feet) 230

(3) static water level (feet) 55 below above top of ground.

(4) casing PVC, 220,
(material) (depth)
(size) If telescope see back.


(5) screen 10, 220
(length) (depth to top)
2, PVC
(size) (material)

(6) pump 1, 10
(HP) (yield gpm)
Elec
(type power)

(7) electric log NO
(yes or no)

(organization running log)

(8) how well bottom plugged Back wash
rate

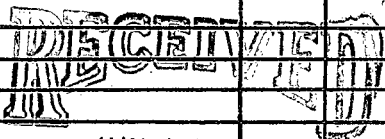


Department of Natural Resources
Bureau of Land & Water Resources

DRILLERS REMARKS:

If well telescopes please sketch and show depths.

GROUND LEVEL

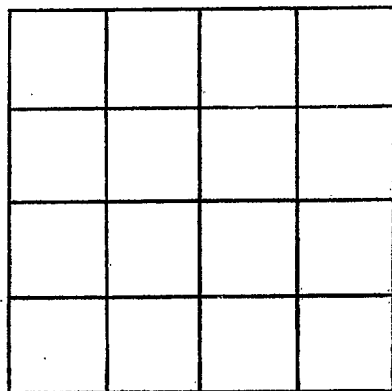

SECTION _____

Please indicate well location X.

ADDITIONAL INFORMATION

If more than one screen,
show locations of each on sketch.