

MISSISSIPPI DEPARTMENT OF NATURAL RESOURCES

Bureau of Land and Water Resources

Southport Mall

P.O. Box 10631

Jackson, Mississippi 39209

WATER WELL DRILLERS LOG

STONE
M 2008

5-1 19 810 Frank Price Stone  
 date well completed firm name county well located

LANDOWNER:	description of formations encountered	from	to
Will Parker			
(mailing address)	Clay	3	175
WELL LOCATION:	medium sand	175	183
sec 17 T 4 N R 10 E S W			
7 miles F of McHenry (distance) (direction) (nearest town)			
WELL PURPOSE: HOME (home, irrigation, municipal, industrial)			
WELL COMPLETION DATA:			
(1) diameter (inches) 2"			
(2) total depth (feet) 183'			
(3) static water level (feet) 50' below top of ground.			
(4) casing PVC, 183' (material) (depth)			
(size) If telescope see back.			
(5) screen 25', 183' (length) (depth to top)			
2" PVC (size) (material)			
(6) pump 1 (HP) 8 (yield gpm) Elect. (type power)			
(7) electric log NO. (yes or no)			
(organization running log)			
(8) how well bottom plugged B.W.V.			


RECEIVED  
 2/25  
 AUG 18 1986

Department of Natural Resources  
 Bureau of Land & Water Resources

DRILLERS REMARKS:

If well telescopes please sketch and show depths.

GROUND LEVEL

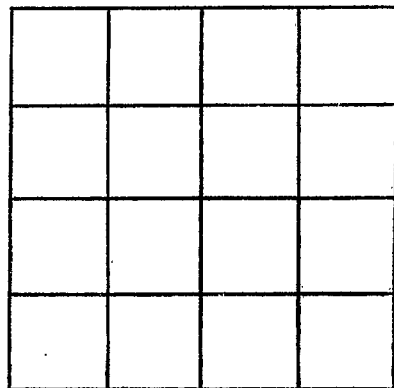

SECTION \_\_\_\_\_

Please indicate well location X.

ADDITIONAL INFORMATION

If more than one screen,  
show locations of each on sketch.