

# MISSISSIPPI DEPARTMENT OF NATURAL RESOURCES

Bureau of Land and Water Resources

Uncoated  
 Steel  
 WELL NUMBER: M 2009    CODED  
 DATE WELL COMPLETED: 10-3-86

PERMIT NUMBER  
 NAME OF DRILLING FIRM:  
Coast water well

P.O. Box 10631  
 Jackson, Mississippi 39209  
**WATER WELL DRILLERS LOG**

NAME & MAILING ADDRESS OF LANDOWNER:  
Knob Hill Hunting Club  
McHenry Rd.  
Perkenston MS  
 WELL LOCATION:    SEC: 20    TOWNSHIP: N 10 E    RANGE: 10  
 DISTANCE: 6 1/2 Miles    DIRECTION: S.E.    NEAREST TOWN: Wiggins  
 OTHER LANDMARK:  
 WELL PURPOSE: Home, Irrigation, Municipal, Industrial, Fish Pond, etc.  
Camp - (home)

**PUMP DATA**

PUMP TYPE (Circle One):  
 Submersible,    Turbine,    Jet    Flowing Well,  
 Other (Describe) \_\_\_\_\_  
 POWER TYPE (Circle One):  
 Electric,    Tractor,    Diesel,    Gasoline,    Butane,  
 Other (Describe) \_\_\_\_\_  
 Pump Capacity (GPM)    No. of Stages    Setting Depth  
 \_\_\_\_\_    \_\_\_\_\_    \_\_\_\_\_ FT.  
 PUMP TEST  
 Well yielded \_\_\_\_\_ GPM with  
 a drawdown of \_\_\_\_\_ ft.  
 after \_\_\_\_\_ hours of pumping

**WELL DATA**

Well Depth <u>75'</u>	Casing Diameter (In.) <u>2"</u>	Casing Length (Ft.) <u>60'</u>
Type of Casing <u>PVC</u>	Hole Depth <u>75'</u>	Depth to Static Water Level <u>16'</u>

TYPE OF COMPLETION: (Circle One or More):  
 Gravel Packed     Underreamed     Telescoped,  
 Natural Development     Open Hole     Other  
 (Describe) \_\_\_\_\_  
 Top of Lap Pipe or Reduction in Casing  
 FEET    IF TELESCOPED OR MORE THAN ONE SCREEN: USE BACK PAGE

**LOG DATA**

TYPE OF LOG RUN (Circle One):  
 Electric,    Gamma Ray,    Density,    Sonic,    No Log Run,    Neutron,  
 Other (Describe) \_\_\_\_\_  
 Name of Organization Running Log

**SCREEN DATA**

Diameter - Inches <u>2"</u>	Length - Feet <u>10'</u>	Slot Size - Inches <u>.008</u>
Screen Type <u>PVC</u>	Depth to Bottom - Feet <u>70'</u>	

**GEOLOGIC DATA (Office Use Only)**

Surface Elev.	Geologic Unit	Unit Thickness	Depth to Top
Subs. SWL	Date	Analysis	Aquifer Test

Driller's Remarks

DESCRIPTION OF FORMATIONS ENCOUNTERED	FROM	TO	FORMATIONS (Continued)	FROM	TO
<u>Top Soil</u>	<u>0</u>	<u>1</u>			
<u>Red Clay</u>	<u>1</u>	<u>10</u>			
<u>Red Fine Sand</u>	<u>10</u>	<u>25</u>			
<u>Red Med Sand</u>	<u>25</u>	<u>32</u>			
<u>Red Coarse Sand</u>	<u>32</u>	<u>70</u>			
<u>Red Coarse Sand</u>	<u>70</u>	<u>75</u>			
<u>+ Gravel</u>					

RECEIVED


NOV 24 1986

Department of Natural Resources  
 Bureau of Land & Water Resources

IF MORE SPACE IS NEEDED, USE BACK

If well telescopes please sketch and show depths.

GROUND LEVEL

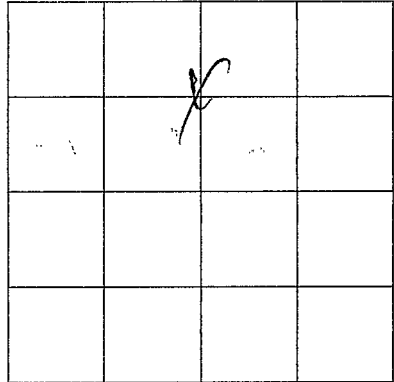

SECTION 20

Please indicate well location X.

ADDITIONAL INFORMATION

If more than one screen, show location of each on sketch.