

MISSISSIPPI DEPARTMENT OF ENVIRONMENTAL QUALITY
Bureau of Land and Water Resources

P. O. Box 10631
Jackson, MS 39289-0631
WATER WELL DRILLERS LOG

COUNTY, WELL LOCATED Stone	
WELL NUMBER M	CODED
DATE WELL COMPLETED 200 8-6-91	

PERMIT NUMBER
NAME OF DRILLING FIRM Boone's Water Well

NAME & MAILING ADDRESS OF LANDOWNER Howard Daughdrill			
65 Daughdrill Rd			
Wiggins Rd ms 39577			
WELL LOCATION:	SEC	TOWNSHIP	RANGE
	17	4	N 13 W
DISTANCE	DIRECTION	NEAREST TOWN	
13 Miles	E	of LYON	
OTHER LANDMARK			
WELL PURPOSE: Home, Irrigation, Municipal, Industrial, <u>Fish Pond</u> etc.			

PUMP DATA		
PUMP TYPE (Circle One): <u>Submersible</u> , Turbine, Jet, Flowing Well, Other (Describe) _____		
POWER TYPE (Circle One): <u>Electric</u> , Tractor, Diesel, Gasoline, Butane, Other (Describe) _____ H/P 2		
Pump Capacity (GPM) 75	No. of Stages	Setting Depth FT.
PUMP TEST		
Well yielded _____ GPM with a drawdown of _____ ft. after _____ hours of pumping		

WELL DATA		
Well Depth 70	Casing Diameter (In.) 4"	Casing Length (Ft.) 50
Type of Casing Sch 40	Hole Depth 70	Depth to Static Water Level
TYPE OF COMPLETION: (Circle One or More): <u>Gravel Packed</u> , Underreamed, Telescoped, Natural Development, Open Hole, Other (Describe) _____		
Top of Lap Pipe or Reduction in Casing		
FEET	IF TELESCOPED OR MORE THAN ONE SCREEN: USE BACK PAGE	

LOG DATA	
TYPE OF LOG RUN (Circle One): No Log Run, Electric, Gamma Ray, Density, Sonic, Neutron, Other (Describe) _____	
Name of Organization Running Log	

SCREEN DATA		
Diameter - Inches 4"	Length - Feet 20	Slot Size - Inches # 10
Screen Type Sch 40	Depth to Bottom - Feet	

GEOLOGIC DATA (Office Use Only)			
Surface Elev.	Geologic Unit	Unit Thickness	Depth to Top
Subs. SWL	Date	Analysis	Aquifer Test


Driller's Remarks

DESCRIPTION OF FORMATIONS ENCOUNTERED	FROM	TO
Clay	0	30
Sand	30	70

FORMATIONS (Continued)	FROM	TO
15 G 15 V 15 S 10		
DEC 31 1991		
Dept. of Environmental Quality Bureau of Land & Water Resources		
IF MORE SPACE IS NEEDED, USE BACK		

If well telescopes please
sketch and show depths.

GROUND LEVEL

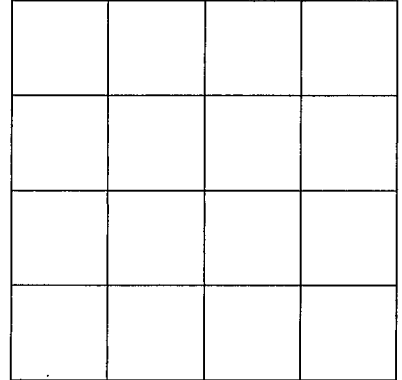

SECTION _____

Please indicate well location X.

ADDITIONAL INFORMATION

If more than one screen,
show location of each on sketch.