

DEQ

MISSISSIPPI DEPARTMENT OF ENVIRONMENTAL QUALITY
Office of Land and Water Resources
P. O. Box 2309
Jackson, MS 39225
Water Well Plugging/Decommissioning Form
OLWR-DF-1 (04/08)

no drill log

COUNTY WELL LOCATED: Sunflower		WELL NUMBER: A
PERMIT NUMBER: 10590	DATE WELL PLUGGED: 9-11-2019	
NAME OF FIRM PLUGGING WELL: Irrigation Equipment Inc.		TELEPHONE NUMBER: 662-887-2555
NAME AND ADDRESS OF CURRENT LANDOWNER: Indian Mound Farm Box 926 Aberdeen MS 39730 662-466-3066		
WELL LOCATION: NE/SE SECTION: 1 TOWNSHIP: 24N RANGE: 4W		
WELL LOCATION: LATITUDE: 33 58 35.4	LONGITUDE: 90 33 32.5	METHOD (CIRCLE ONE): (1) USGS QUAD (2) CONVENTIONAL SURVEY (3) GPS - HAND HELD OR SURVEY GRADE
DISTANCE:	DIRECTION:	NEAREST TOWN: Rome OTHER LANDMARK:
WELL PURPOSE (HOME, IRRIGATION, MUNICIPAL, ETC.): Irrigation		
NAME OF WELL CONTRACTOR WHO DRILLED THE WELL:		
NAME OF LANDOWNER WHEN WELL WAS DRILLED:		

WELL DATA			
WELL DEPTH: 59Ft.	HOLE DEPTH:		
CASING DIAMETER (IN.): 12	CASING LENGTH (FT.):	TYPE OF CASING: Steel	
DEPTH TO STATIC WATER LEVEL: 48Ft.	DATE WELL COMPLETED:		
WHY IS THE WELL BEING ABANDONED? Empty Well Casing			

DESCRIBE HOW THE WELL OR HOLE WAS PLUGGED (AMOUNT OF CASING AND/OR SCREEN THAT WAS REMOVED OR LEFT IN HOLE, MATERIAL AND AMOUNT USED IN PLUGGING, METHOD OF PLACING MATERIAL, ETC.)

Removed casing below ground level. Installed 5% chlorine bleach. Installed sand & gravel. Installed bentonite hole plug.


RECEIVED
OCT 20 2019
BY OLWR

I CERTIFY THAT THE WELL WAS PLUGGED OR ABANDONED IN ACCORDANCE WITH THE STATE OF MISSISSIPPI REGULATIONS.

Patrick M Chism 0695

 MS LICENSE NUMBER
10-14-2019

SIGNATURE DATE

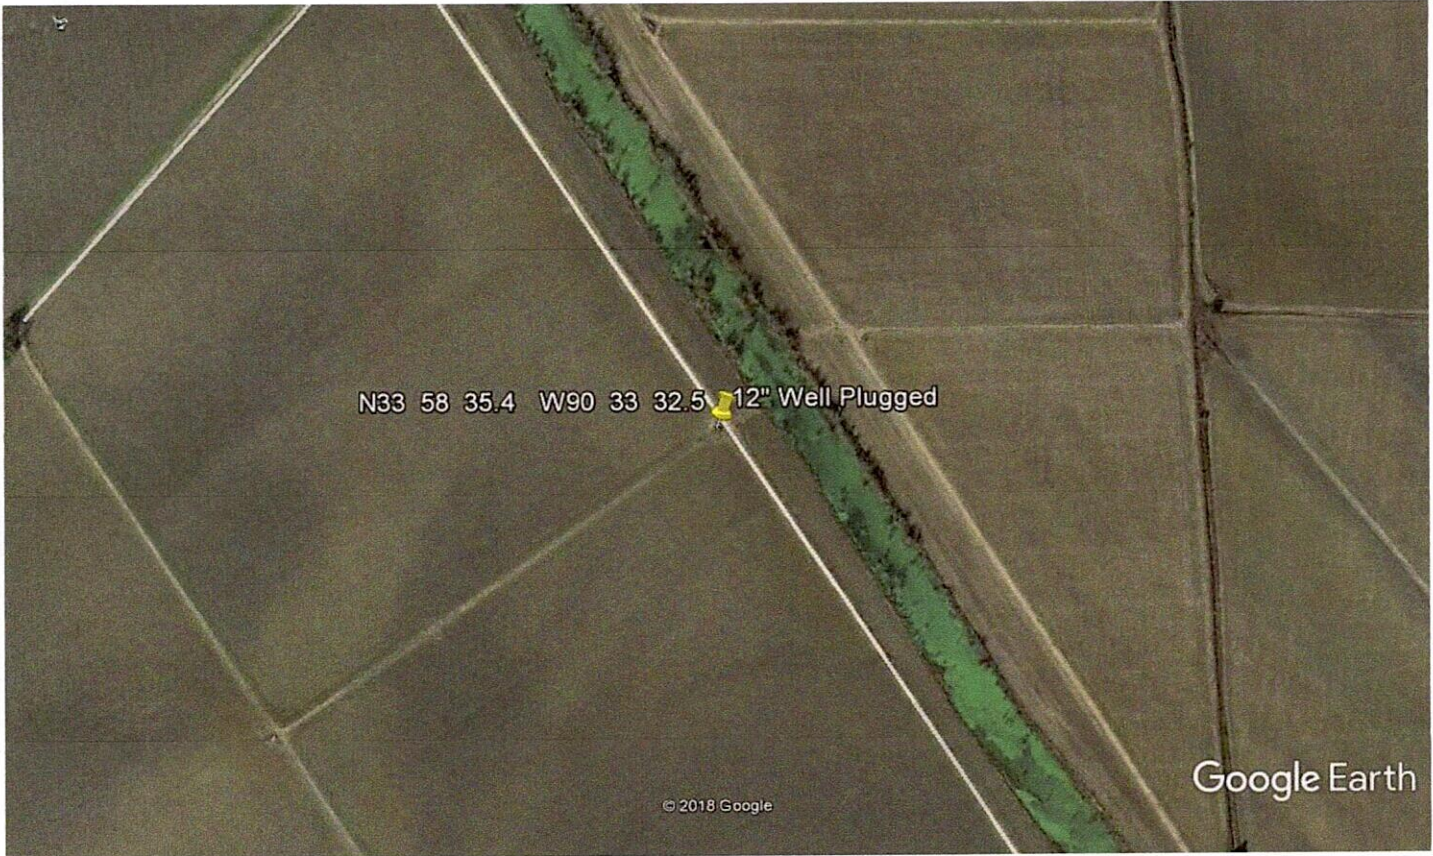

Google Earth



RECEIVED
OCT 20 2019
BY OLWR