

A 9

6-10-65

WATER WELL DRILLERS LOG

CODED

SUNFLOWER

Date: 6-10, 1965, Driller: JIVE COUNTY FARMERS ^{ASSN} County: OSHER

(Name)

(1) Owner of Land: BOND ~~TRUST~~ CO
(Name)
Shelby Miss
(Address)
 (2) Location: 34 33 74 RT.
1/4, 1/4, Sec
1/4 miles East, of LEMBARD
(distance) (direction) (Nearest Town)
 (3) Topography: Flat
(Hilly) (Flat) (Level)
 (4) Purpose of Well: IRRIGATION
(Domestic Irrigation Municipal, Industrial, Other)


Description & Color of Materials Sand, Clay, Red Clay, Shell, etc.	Thick- ness Feet	Depth Feet
GUMBO -	14 1/2	14 1/2
GUMBO	6 1/2	21
FINE SAND	13	34
BLUE MUD	6 1/2	40 1/2
FINE SAND	13	53 1/2
COARSE SAND	26	79 1/2
COARSE SAND LOTS OF GRAVEL	13	92 1/2
Large gravel & rock	6 1/2	99
A little FINE SAND -		
MOSTLY COARSE SAND		
& Rock	15	114
BOTTOM SOLID ROCK		

Information upon completion of well:

(1) Diameter 6 inches.
 (2) Total Depth 109 feet.
 (3) Water Level 19' 8" feet below top of ground.
 (4) Cased to 61, Size 6"
 (5) Screen: Size 6", Length 48"
 (6) Were any formations sealed against pollution?
 _____ yes, no.

If YES depth of formation _____
 Why _____
 Drillers Remarks: _____

CODED

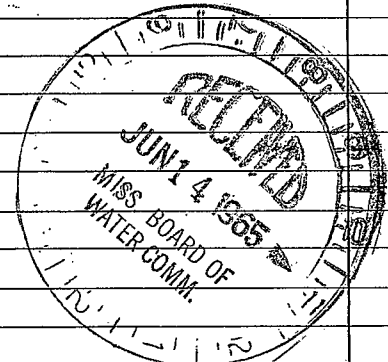

[Handwritten signature]

Well No.

(Use Back Side)

1952

1952