

Sunflower
A 10
5/23/75

MISSISSIPPI
 BOARD OF WATER COMMISSIONERS
 416 North State Street
 Jackson, Mississippi 39201

WATER WELL DRILLERS LOG

Smiley Payne

Sunflower

CODED

5/23 1975 date well completed
 Bolivar county well located
 firm name


LANDOWNER: <u>Al Ervin</u>	description of formations encountered	from	to
P. O. Box 148 Merigold, MS (mailing address)			
WELL LOCATION: sec. <u>28</u> T. <u>24</u> N R. <u>4</u> E 154 <u>1 1/2</u> miles <u>N</u> of <u>Lombardy</u> (distance) (direction) (nearest town)	Clay	0	21'
WELL PURPOSE: <u>irrigation</u> (home, irrigation, municipal, industrial)	Fine sand	21	36'
WELL COMPLETION DATA: (1) diameter (inches) <u>12"</u> (2) total depth (feet) <u>94</u> (3) static water level (feet) <u>21</u> below top of ground. <u>above</u> (4) casing <u>steel</u> <u>44'</u> (material) (depth) <u>12"</u> if telescope see back. (size) (5) screen <u>50'</u> <u>44'</u> (length) (depth to top) <u>12"</u> <u>steel</u> (size) (material) (6) pump <u>30</u> <u>1800</u> (HP) (yield gpm) <u>gear drive</u> (type power) (7) electric log <u>no</u> (yes or no) (organization running log) (8) how well bottom plugged <u>plate</u>	Coarse sand	36	62'
	Coarse sand & pea gravel	62	75'
	Coarse sand and gravel	75	94'
DRILLERS REMARKS:			

CODED

INSPECTION
 APR 27 1975
 MISS. Bd. OF WATER COMMISSIONERS

If well telescopes please sketch and show depths.

GROUND LEVEL

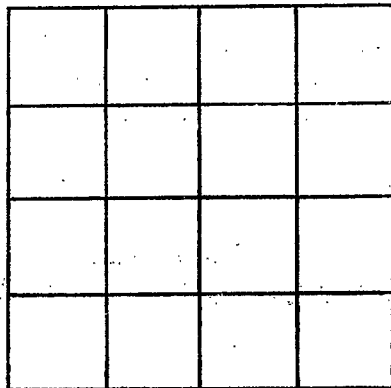

SECTION _____

Please indicate well location X.

ADDITIONAL INFORMATION

If more than one screen,
show locations of each on sketch.