

SUNFLOWER
All
C-11-76
E Log #64

MISSISSIPPI
 BOARD OF WATER COMMISSIONERS
 416 North State Street
 Jackson, Mississippi 39201

CODED

WATER WELL DRILLERS LOG

June 11 19 76 Bruce Berryman-Greenwood. Sunflower
 date well completed firm name county well located


LANDOWNER:	Description of formations encountered	from	to
Radcliff Investment Companies	Clay	0	20
P.O. Box 610, West Memphis, Arkansas 72301	Sand	20	80
(mailing address)	Sand & Gravel	80	140
	Clay	140	160
WELL LOCATION:	Clay & Str. sand	160	200
sec. 33 T. 24 N R. 4 E	Sand	200	240
6 miles NW of Drew	Clay & Str. sand	240	280
(distance) (direction) (nearest town)	Sandy shale	280	400
WELL PURPOSE: Home	Clay	400	600
(home, irrigation, municipal, industrial)	Clay & Str. sand	600	640
WELL COMPLETION DATA:	Sand	640	660
(1) diameter (inches) 4" x 2"	Clay & str. sand	660	705
(2) total depth (feet) 1270 ft.	Sand	705	715
(3) static water level (feet) 4 below top of ground	Clay	715	760
(4) casing 4" blk. - 126 ft.	Shale	760	810
2" galv. - 1113 ft.	Brown sand	810	820
(material) (depth)	Shale	820	870
(size) if telescope see back.	Sandy shale	870	890
(5) screen 20 ft., 1250 ft.	Green sand	890	900
(length) (depth to top)	Shale	900	910
.010, Stainless steel	Sand	910	920
(size) (material)	Clay	920	950
(6) pump 2 50	Sand	950	970
(HP) (yield gpm)	Clay	970	990
Electric	Shale	990	1120
(type power)	Hard Clay	1120	1140
(7) electric log Yes	Clay	1140	1235
(yes or no)	Sand	1235	1295
Miss Geological Survey			
(organization running log)			
(8) how well bottom plugged B.P.V			
DRILLERS REMARKS:			

RECEIVED
 OCT 5 1976

MISS. BD. OF WATER COMM.

If well telescopes please sketch and show depths.

GROUND LEVEL

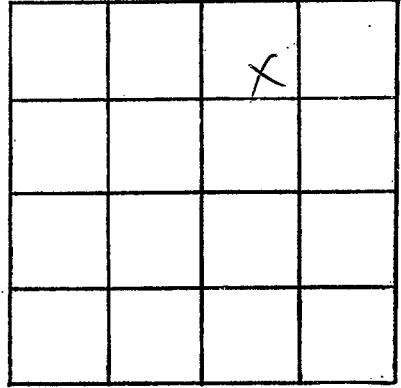

SECTION 33

Please indicate well location X.

ADDITIONAL INFORMATION

If more than one screen,
show locations of each on sketch.