

SUNFLOWER  
A 12  
10-13-77

MISSISSIPPI  
BOARD OF WATER COMMISSIONERS  
416 North State Street  
Jackson, Mississippi 39201

CODED

WATER WELL DRILLERS LOG

10-13 date well completed 1977 Five County Farms firm name Sunflower county well located

LANDOWNER: Joe Stevens

description of formations encountered

from to

(mailing address)

WELL LOCATION:

sec. 1 T 24 N R 4 E  
S W  
2 miles East of Baltan  
(distance) (direction) (nearest town)

WELL PURPOSE: drinking  
(home, irrigation, municipal, industrial)

CODED

WELL COMPLETION DATA:

- (1) diameter (inches) 12"
- (2) total depth (feet) 107
- (3) static water level (feet) 23 below above top of ground.
- (4) casing PVC 62  
(material) (depth)  
12" if telescope see back.  
(size)
- (5) screen 240' 62'  
(length) (depth to top)  
12" PVC  
(size) (material)
- (6) pump 40 2200  
(HP) (yield gpm)  
(type power)
- (7) electric log NO  
(yes or no)  
(organization running log)
- (8) how well bottom plugged cap

Top Soil	0	12
fine sand	12	30
med sand	30	50
sand & gravel	50	107


DRILLERS REMARKS:

RECEIVED  
NOV 21 1977

MISS. BD. OF WATER COMMISSIONERS

If well telescopes please sketch and show depths.

GROUND LEVEL

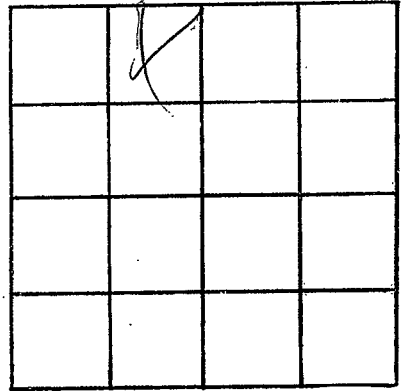

SECTION \_\_\_\_\_

Please indicate well location X.

ADDITIONAL INFORMATION

If more than one screen,  
show locations of each on sketch.