

SUNFLOWER

A 20

6-8-59

MISSISSIPPI BOARD OF WATER COMMISSIONERS 416 North State Street Jackson, Mississippi 39201

CODED

0667

WATER WELL DRILLERS LOG

June 8, 1959 Layne-Central Company Sunflower date well completed firm name county well located

Table with columns: LANDOWNER, WELL LOCATION, WELL PURPOSE, WELL COMPLETION DATA, description of formations encountered, from, to. Includes handwritten notes like 'PH 7.5', 'IRON (Fe) 22 PPM', and 'CODED'.

LANDOWNER: Miss. State Pen North of old Maximum Security Parchman, Mississippi (mailing address)

WELL LOCATION: NW SE sec. 13 T. 24 N. R. 4 E S W of Parchman (distance) miles (direction) of (nearest town)

WELL PURPOSE: domestic use (home, irrigation, municipal, industrial)

WELL COMPLETION DATA: (1) diameter (inches) 10"x8"x6" (2) total depth (feet) 491'10" (3) static water level (feet) 18' below top of ground 8"x6" lead seal (4) casing steel 435'7" (material) (depth) 10" & 8" (size) If telescope see back. (5) screen 50' 486'10" (length) (depth to top) 6" stainless steel (size) (material) 5' of 6" B.P.V. (6) pump 15 (HP) 200 (yield gpm) electric (type power) (7) electric log no (yes or no) (organization running log) (8) how well bottom plugged B.P.V.


Table with columns: description of formations encountered, from, to. Rows include Clay, Grey sand, Sand & gravel, Clay, Fine sand, Sand clay strks., Sandy shale, Sand & clay strks., Sand, Clay, Sand, Tough clay, Fine sand clay strks., Fine sand, PK Sand medium, Clay.

PH 7.5 IRON (Fe) 22 PPM CODED

DRILLERS REMARKS:

If well telescopes please sketch and show depths.

GROUND LEVEL

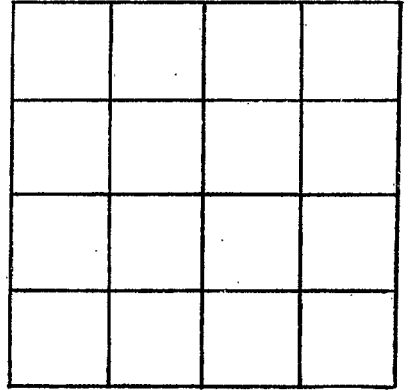

SECTION _____

Please indicate well location X.

ADDITIONAL INFORMATION

If more than one screen,
show locations of each on sketch.