

Bolivar

E-17

7-26-71

Sunflower ^{A 22} MISSISSIPPI ^{A 22}

BOARD OF WATER COMMISSIONERS

416 North State Street

Jackson, Mississippi 39201

CODED

WATER WELL DRILLERS LOG

7/26
date well completed

1971 Dillard & Supply
firm name

Bolivar
county well located

LANDOWNER:

H. L. McSwain

Margaret Miss.
(mailing address)

description of formations encountered

Top soil

Clay

Light Clay

Sancti Big gravel with old shales

Sand shale

Blue clay

from

to

0 30

30 30

30 67

19 96

96 99

99 ?

WELL LOCATION:

sec. 5 T. 34 N. R. 4 E

7 miles East of Shelby
(distance) (direction) (nearest town)

WELL PURPOSE: Drinking
(home, irrigation, municipal, industrial)

WELL COMPLETION DATA:

(1) diameter (inches) 16

(2) total depth (feet) _____

(3) static water level (feet) 32 below above top of ground.

(4) casing steel
(material) (depth)

_____ if telescope see back.
(size)

(5) screen 40
(length) (depth to top)

16 steel
(size) (material)

(6) pump 2.5 1500
(HP) (yield gpm)

Diesel
(type power)

(7) electric log no
(yes or no)

_____ (organization running log)

(8) how well bottom plugged concrete

CODED


AUG 2 1971

MISS. BD. OF
WATER COMM.

DRILLERS REMARKS:

If well telescopes please
sketch and show depths.

GROUND LEVEL

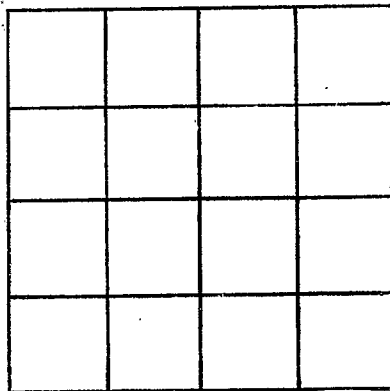

SECTION _____

Please indicate well location X.

ADDITIONAL INFORMATION

If more than one screen,
show locations of each on sketch.