

SUNFLOWER
A 23
4-1-75

MISSISSIPPI
 BOARD OF WATER COMMISSIONERS
 416 North State Street
 Jackson, Mississippi 39201 **CODED**

WATER WELL DRILLERS LOG

4-1 1975 Datura with the Sunflower
 date well completed firm name county well located

LANDOWNER:
Storkman & Lane
Shelby Miss.
 (mailing address)

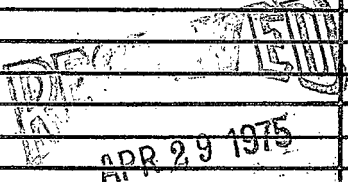
description of formations encountered	from	to
<u>Loam soil</u>	<u>0</u>	<u>22</u>
<u>Blue sand</u>	<u>22</u>	<u>42</u>
<u>sand</u>	<u>42</u>	<u>60</u>
<u>sand & gravel</u>	<u>60</u>	<u>110</u>
<u>Bottom rock clay</u>		

WELL LOCATION:
 sec 19 T 24 N R 4 E
5 miles East of Shelby
 (distance) (direction) (nearest town)

WELL PURPOSE: Irrigation
 (home, irrigation, municipal, industrial)

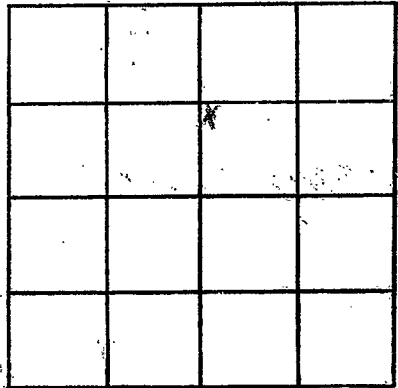
- WELL COMPLETION DATA:
- (1) diameter (inches) 16
 - (2) total depth (feet) 110
 - (3) static water level (feet) 21 below above top of ground.
 - (4) casing Steel (material) (depth)
 - (size) If telescope see back.
 - (5) screen 40 (length) (depth to top)
 - 16 (size) Steel (material)
 - (6) pump 60 (HP) 2600 (yield gpm)
 - Diesel (type power)
 - (7) electric log No (yes or no)
 - (organization running log)
 - (8) how well bottom plugged Steel Plate

DRILLERS REMARKS:

CODED

 APR 29 1975
 MISS. RD. OF WATER COMMISSIONERS

If well telescopes please sketch and show depths.

GROUND LEVEL



SECTION 19

Please indicate well location X.

ADDITIONAL INFORMATION

If more than one screen,
show locations of each on sketch.