

SUNFLOWER
A 24
4-11-75

MISSISSIPPI
 BOARD OF WATER COMMISSIONERS
 416 North State Street
 Jackson, Mississippi 39201

CODED

WATER WELL DRILLERS LOG

4/11 1975 Delta Well Drilling Sunflower
 date well completed firm name county well located

LANDOWNER: Walter Lane
Shelby Miss.
 (mailing address)

description of formations encountered	from	to
<u>Top</u>	<u>0</u>	<u>24</u>
<u>Thin sand</u>	<u>24</u>	<u>48</u>
<u>sand & gravel</u>	<u>48</u>	<u>103</u>
<u>Red brick</u>		

WELL LOCATION:
 sec. 19 T 24 N R. 4 E
5 miles East of Shelby
 (distance) (direction) (nearest town)

WELL PURPOSE: Domestic
 (home, irrigation, municipal, industrial)

- WELL COMPLETION DATA:
- (1) diameter (inches) 16
 - (2) total depth (feet) 103
 - (3) static water level (feet) 20 below above top of ground.
 - (4) casing steel (material) (depth)
 - (size) If telescope see back.
 - (5) screen 110 (length) (depth to top)
 - 16 (size) steel (material)
 - (6) pump 60 (HP) 3600 (yield gpm)
 - Quess (type power)
 - (7) electric log No (yes or no)
 - (organization running log)
 - (8) how well bottom plugged steel plate

DRILLERS REMARKS:


CODED

RECEIVED
APR 20 1975

MISS. BD. OF WATER

If well telescopes please sketch and show depths.

GROUND LEVEL

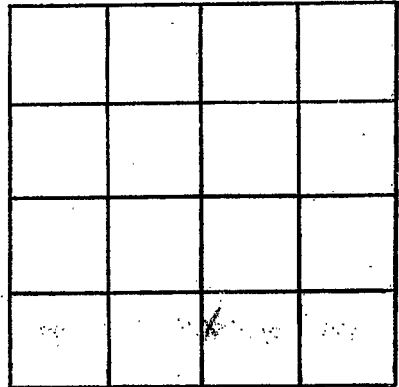

SECTION X9

Please indicate well location X.

ADDITIONAL INFORMATION

If more than one screen,
show locations of each on sketch.