

Sumflower
A 25
11-66

MISSISSIPPI BOARD OF WATER COMMISSIONERS

WATER WELL DRILLERS LOG

COILED

Date: 11-18-1966, Driller: JACKSON COUNTY FARMERS ASSN County Sumflower
(Name)

(1) Owner of Land: Joe J. Stevens
(Name)
R F D, Tutwiler, Miss.
(Address)
West Pine Center
(2) Location: 1/4, NE 1/4, Sec. 1 T24N R4W
1 miles NE of Baltes
(distance) (direction) (Nearest Town)
(3) Topography: Flat
(Hilly) (Flat) (Level)
(4) Purpose of Well: Irrigation
(Domestic Irrigation, Municipal, Industrial, Other)


Description & Color of Materials Sand, Clay, Red Clay, Shell, etc.	Thick- ness Feet	Depth Feet
<u>Buckshot + Clay</u>		<u>27</u>
<u>Sand + Clay layers</u>	<u>38</u>	<u>65</u>
<u>Blue Clay</u>	<u>7 1/2</u>	<u>72 1/2</u>
<u>Fine Sand Small Rock + a trace of Clay</u>	<u>7 1/2</u>	<u>79</u>
<u>Coarse Sand + Pea rock</u>	<u>16 1/2</u>	<u>85 1/2</u>
<u>Med Sand + gravel</u>	<u>5</u>	<u>90 1/2</u>
<u>Coarse Sand + Rocks</u>	<u>14 1/2</u>	<u>105</u>
<u>Coarse Sand + Large Gravel</u>	<u>11</u>	<u>116</u>
<u>Clay</u>	<u>2</u>	<u>118</u>
<u>White Fine Sand with medium gravel</u>	<u>11</u>	<u>129</u>

Information upon completion of well:

(1) Diameter 16 inches.
(2) Total Depth 125' 4" feet.
(3) Water Level 18 feet below top of ground.
(4) Cased to 77' 4", Size 16"
(5) Screen: Size 16", Length 48"
(6) Were any formations sealed against pollution?
no yes, no

If YES depth of formation _____
Why _____

Drillers Remarks: _____

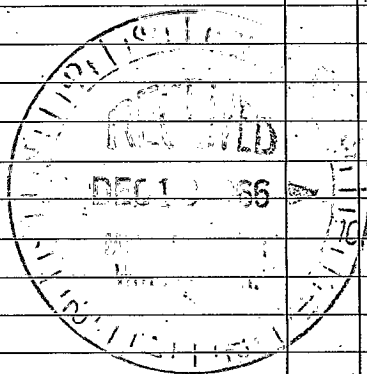

[Handwritten Signature]

(Use Back Side)

Well No.

