

111
1000

SUNFLOWER
A 27
5-68

MISSISSIPPI
BOARD OF WATER COMMISSIONERS
416 North State Street
Jackson, Mississippi 39201

WATER WELL DRILLERS LOG

5-8 ' date well completed 1968 FIVE COUNTY FARMERS ASSN. firm name SUNFLOWER county well located

LANDOWNER: BONDS MERE CO

SHELBY MISS
(mailing address)

description of formations encountered	from	to
Yellow Clay		14'
Coarse Fine Sand	6 1/2'	20 1/2'
Clay & Sand	6 1/2'	27'
MEDIUM SAND	19 1/2'	53'
MEDIUM TO COARSE SAND	19 1/2'	66'
Coarse Sand & Gravel		131'

WELL LOCATION:
sec. 27 T 24 N R 4 E
S W
1 1/2 miles NE of Lombardy
(distance) (direction) (nearest town)

WELL PURPOSE:
(home, irrigation, municipal, industrial)

WELL COMPLETION DATA:

(1) diameter (inches) 6

(2) total depth (feet) 126

(3) static water level (feet) 23 ⁴/₅ below above top of ground. *Well took water fast*

(4) casing Pipe, 78,
(material) (depth)
6 if telescope see back.
(size)

(5) screen 48, 78
(length) (depth to top)
6, Doerlot
(size) (material)

(6) pump 40, 1000
(HP) (yield gpm)
NOT DEFINITE yet.
(type power)

(7) electric log NO
(yes or no)
(organization running log)

(8) how well bottom plugged Welded


MAY 13 1968

MISS. BD. OF
WATER COM. 2

DRILLERS REMARKS:

If well telescopes please sketch and show depths.

GROUND LEVEL

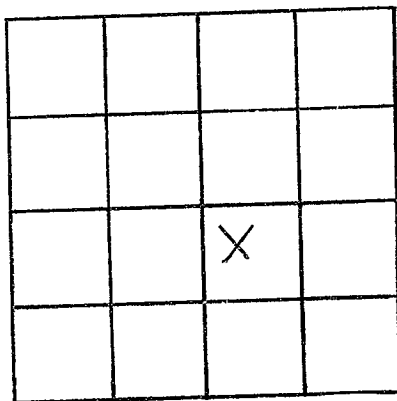

SECTION 27

Please indicate well location X.

ADDITIONAL INFORMATION

If more than one screen,
show locations of each on sketch.