

Sunflower
A 28
6-68

MISSISSIPPI
 BOARD OF WATER COMMISSIONERS
 416 North State Street
 Jackson, Mississippi 39201

CODED

WATER WELL DRILLERS LOG

June 18 1968 Five County Farmers Sunflower
 date well completed firm name county well located
asm-

LANDOWNER: Board Merc Co
Shelby Miss
 (mailing address)

WELL LOCATION:
 sec 33 T 22 N R 4 W
1/2 miles West of Lumbardy
 (distance) (direction) (nearest town)

WELL PURPOSE: IRRIGATION
 (home, irrigation, municipal, industrial)

WELL COMPLETION DATA:

(1) diameter (inches) 6

(2) total depth (feet) 126³

(3) static water level (feet) 27 below above top of ground.

(4) casing Pipe 78³
 (material) (depth)
6 if telescope see back.
 (size)

(5) screen 48 78³
 (length) (depth to top)
6 Open 101
 (size) (material)

(6) pump 40 1000
 (HP) (yield gpm)
Diesel
 (type power)

(7) electric log _____
 (yes or no)

 (organization running log)

(8) how well bottom plugged Welded


description of formations encountered	from	to
CLAY	0	14
CLAY	14	20 ^{1/2}
CLAY streaked with SAND	20 ^{1/2}	27
CLAY & FINE SAND	27	33 ^{1/2}
CLAY & FINE RED SAND streaked Blue Clay	33 ^{1/2}	40
and FINE SAND	40	53
BLUE CLAY	53	66
Fine Sand	66	85
MED SAND	85	105
MED SAND & Peb Rock	105	113
MED SAND (Rock) GRAVEL	113	116
FINE SAND with some yellow clay	116	131

JUN 21 1968
 MISS. BOARD OF
 WATER COMM.

DRILLERS REMARKS:

If well telescopes please sketch and show depths.

GROUND LEVEL

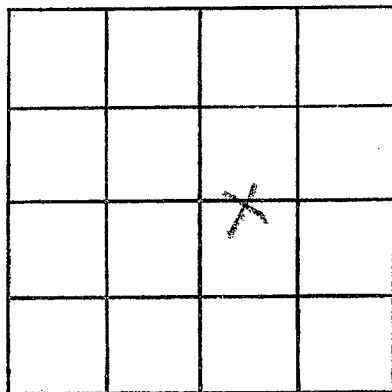

SECTION 33

Please indicate well location X.

ADDITIONAL INFORMATION

If more than one screen, show locations of each on sketch.