

SUNFLOWER
A 29
4/19/78
1

MISSISSIPPI
BOARD OF WATER COMMISSIONERS
416 North State Street
Jackson, Mississippi 39201

CODED

WATER WELL DRILLERS LOG
BUTANE GAS COMPANY

Sunflower
county well located

4-19-78 19
date well completed

OF GREENWOOD

LANDOWNER:	description of formations encountered	from	to
E. D. GRAHAM			
Summer	SAND + Pea Gravel	65	80
(mailing address)	SAND + GRAVEL	80	90
WELL LOCATION:	SAND + Pea Gravel	90	100
sec. <u>36</u> T. <u>24</u> N R. <u>4</u> E	SAND	100	112
or Parchman			
(distance) miles (direction) of (nearest town)			
WELL PURPOSE: <u>IRR</u>			
(home, irrigation, municipal, industrial)			
WELL COMPLETION DATA:			
(1) diameter (inches) <u>16"</u>			
(2) total depth (feet) <u>112</u>			
(3) static water level (feet) _____ below above top of ground.			
(4) casing <u>Steel</u> <u>72</u>			
(material) (depth)			
<u>16"</u> if telescope see back.			
(size)			
(5) screen <u>40</u> <u>72</u>			
(length) (depth to top)			
<u>16"</u> <u>Steel</u>			
(size) (material)			
(6) pump <u>30</u> <u>1800</u>			
(HP) (yield gpm)			
<u>Diesel</u>			
(type power)			
(7) electric log <u>NO</u>			
(yes or no)			
(organization running log)			
(8) how well bottom plugged <u>Steel Plate</u>			
DRILLERS REMARKS:			


CODED

RECEIVED
APR 24 1978

MISS. BD. OF WATER COMM

If well telescopes please sketch and show depths.

GROUND LEVEL

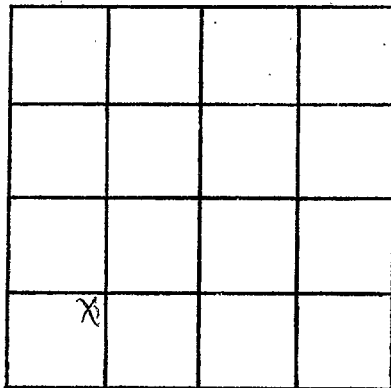

SECTION 36

Please indicate well location X.

ADDITIONAL INFORMATION

If more than one screen, show locations of each on sketch.